

CERTIFIED RECORD OF LAND CORNER MONUMENTATION

History of original corner establishment:


Original survey executed in Sept. 1890 by Emil F. Voigt under instructions dated Aug. 29, 1980.

Set a 4½' post, 4" square, 12" in ground with mound of stone marked "ULS 1" from which:

18" pine bears N61°E 39'

20" pine bears N18°W 28½'

Both scribed "ULS No.1 S. No.220 BT"

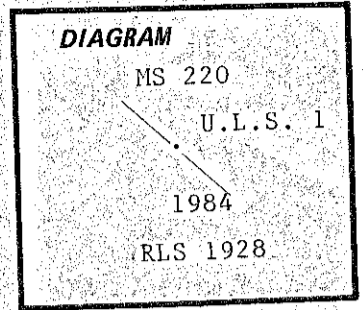

Description of corner evidence found:

Found original rock pile.

Found 36" pine with scar and scribing visible, N. 61°E., 39.0'

Found 20" pine with scribing visible, N.18°W., 28.5'

Both trees had 54-3 and 54-4 tags attached.

Description of monument and accessories I established to perpetuate the original location of this corner:

Set 30" long aluminum pipe with 3¼" aluminum cap marked as shown above, 6" above ground. Steel post with signs 54-9 & 54-2 set next to cap.

Scribed:

9" pine N.72°W. 28.9' "ULS 1 BT"

Attached signs 54-3 & 54-9 and nailed aluminum washer stamped "RLS 1928" by "BT" scribe on new tree. Painted blazes red and a 6" red band around all trees.

REGISTERED
PROFESSIONAL
LAND SURVEYOR

1-20-86

Duane Fehring

OREGON
JULY 13, 1984
DUANE FEHRINGER
2118

Office of..... County of.....
State of....., I hereby certify that the within instrument was filed in this office
for record on the..... day of....., 19.....

(COUNTY OFFICIAL)

(DEPUTY)

FILED May 9 1986
BAKER COUNTY SURVEYOR
SURVEY NO. 8-111-75