

CERTIFIED RECORD OF LAND CORNER MONUMENTATION


History of original corner establishment:

Original survey executed in Sept. 1890 by Emil F. Voigt under instructions dated Aug. 29, 1980.

Set post 4½' long, 4" square, 12" in ground with mound of stone marked "ULS 2 S220" from which:

A rock 28"x32" base, 23" above ground marked with a cross bears S84E 55.0'

A rock 30"x18" 16", above ground bears N61E 51.0' marked with a cross.

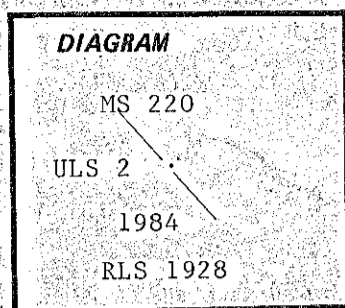

Description of corner evidence found:

Found original rock pile.

Found original bearing objects:

28" x 32" rock 23" above ground with "X" S.84°E. 55.0'

30" x 18" rock 16" above ground with "X" N.61°E. 51.0'

Description of monument and accessories I established to perpetuate the original location of this corner:

Set 30" long aluminum pipe with ¾" aluminum cap, marked as shown above, 10" above ground in rock collar. Steel post with signs 54-9 & 54-2 set next to cap.

Painted original bearing objects red.

REGISTERED
PROFESSIONAL
LAND SURVEYOR

1-20-86

Duane Fehringer

OREGON
JULY 13, 1984
DUANE FEHRINGER
2118

Office of..... County of.....

State of....., I hereby certify that the within instrument was filed in this office

for record on the..... day of....., 19.....

..... by

(COUNTY OFFICIAL)

(DEPUTY)

FILED May 9, 1986

BAKER COUNTY SURVEYOR

SURVEY NO. 8-44-76