


CERTIFIED RECORD OF LAND CORNER MONUMENTATION

History of original corner establishment:

Original survey by W. Barr in 1881, set rock, 10"x10"x8" in mound of stone.

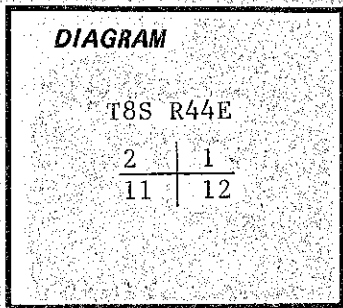


Description of corner evidence found:

Found mound of stone with stone of record size in mound but no marks. Local rancher Alva Mitchell states this mound has been pointed out to him as the corner many years ago and so far as he knows has been the only position considered the corner since.

Description of monument and accessories I established to perpetuate the original location of this corner:

Set a 2"x30" Aluminum pipe with 3/4" aluminum cap, 24" in the ground in center of found mound of stone. Erected larger mound of stone around pipe. 23" Ponderosa Pine, (Southerly fork of a double tree) N63°49'E, 274.4 feet, marked "T8S R44E BT".

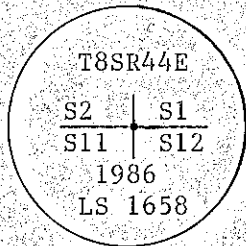

"+" on top of basalt rock outcrop, 5'x3'x1' high, S06°29'W, 103.0 feet.  
 "+" on SE face of basalt outcropping rim of rock averaging about 50 feet long and 2' to 3' high and about 20 feet from the Westerly end. Said "+" bears N46°42'W, 106.6 feet.  
 "+" on top of basalt rock outcrop, 10'x3'x18" high, S59°42'E, 181.5 feet.  
 Signs 54-9 & 54-3 are by each said rock.  
 BT has a 6" red painted band & face & Brass LS washer & signs 54-9 & 54-3 attached. 6 foot steel fence post with signs 54-9 & 54-2 set 3' East.

**REGISTERED  
PROFESSIONAL  
LAND SURVEYOR**

7-10-86  
*Ronald H. Schulson*

**OREGON**  
JULY 14, 1978  
**RONALD H. SCHULSON**  
1658

I, Alva Mitchell having been a resident of the Sparta, Oregon area for many years hereby swear that the mound of stone referred to hereon by Ronald H. Schulson is one I pointed out to him as being accepted as the Section Corner Common to Sections 1, 2, 11 & 12 for at least 50+ years. To the best of my knowledge it is the only point considered to be said Section Corner by any one concerned.

*Alva Mitchell*

Subscribed and sworn to before me, a Notary Public in and for the State of Oregon, this 4th day of August, 1986.

*Mary Wheeler*

My Commission Expires 08/18/87

MARY WHEELER  
NOTARY PUBLIC OREGON  
My Commission Expires

Office of..... County of..... Baker.....

State of....., I hereby certify that the within instrument was filed in this office

for record on the..... day of....., 19.....

..... by .....

(COUNTY OFFICIAL)

(DEPUTY)

FILED June 16, 1986  
BAKER COUNTY SURVEYOR  
SURVEY NO. 8-44-80