


CERTIFIED RECORD OF LAND CORNER MONUMENTATION
 CERTIFIED RECORD OF LAND CORNER MONUMENTATION

History of original corner establishment:

None. original corner establishment.

None.

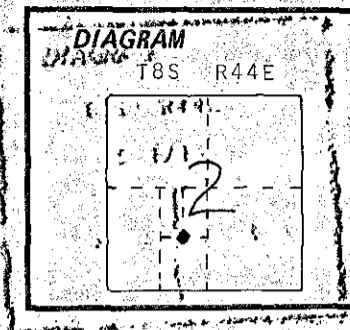


Description of corner evidence found:

None. Description of corner evidence found.

None.

Description of monument and accessories established to perpetuate the original location of this corner:

Description of monument and accessories established to perpetuate the original location of this corner:
 Set 2"x30" alum. pipe with 3/4" alum. cap 26" in the ground in small mound of stone.
 14" Ponderosa Pine N133°39'W, 34.0', mkd., "CESW 1/64 S2 BT".
 13" Ponderosa Pine N68°20'E, 18.4', mkd., "CESW 1/64 S2 BT".
 Set 6" steel post, 5' S and E with 54-9 and 54-2 signs.
 Each BT has 6" painted band and face and brass LS washer and signs 54-9 and 54-3. 5' E and W with signs 54-9 and 54-3.
 E-W fence 16.5' N & N-S fence 46' W. and face of brass LS washer.
 Witnessed by J. David Bampton, LS #2065.65.
 Witnessed by J. David Bampton, LS #2065.65.

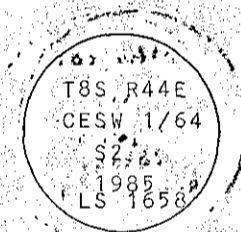

**REGISTERED
 PROFESSIONAL
 LAND SURVEYOR**
 4-30-86
Ronald H. Schulson
OREGON
 JULY 14, 1978
RONALD H. SCHULSON
 1658

Office of..... County of..... Baker.....
 State of....., I hereby certify that the within instrument was filed in this office
 for record on the..... day of..... 19.....
 State of..... by.....
 COUNTY OFFICIAL..... (DEPUTY)

Form R6-7100-57 (9/71)

☆ U.S. GOVERNMENT PRINTING OFFICE - 1983-793-276

Form R6-7100-57 (9/71)

FILED June 16, 1986

BAKER COUNTY SURVEYOR

SURVEY NO. 8-44-81