


CERTIFIED RECORD OF LAND CORNER MONUMENTATION

History of original corner establishment:

None.

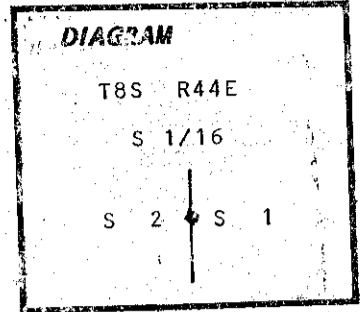


Description of corner evidence found:

None.

Description of monument and accessories established to perpetuate the original location of this corner:

Set 2"x30" alum. pipe with 3/4" alum. cap 24" in the ground in a mound of stone.  
 10" Ponderosa Pine N70°44'E, 43.0', mkd., "S 1/16 S1 BT".  
 14" Douglas Fir S01°11'W, 34.1', mkd., "S. 1/16 S2 BT".  
 Set 6' steel post 5' E and W with signs 54-9 and 54-2.  
 Each BT has a 6" red painted band, and face and brass LS washer and 54-9 and 54-3 signs.  
 Witnessed by J. David Brinton, LS #2065.

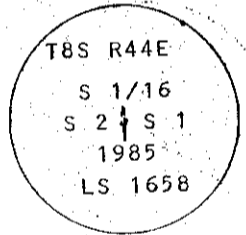

REGISTERED PROFESSIONAL LAND SURVEYOR

4-30-86  
Ronald H. Schulson

OREGON  
JULY 14 1978  
RONALD H. SCHULSON  
1658

Office of..... County of Baker

State of..... I hereby certify that the within instrument was filed in this office for record on the..... day of..... 1986

..... by ..... (DEPUTY)

Form R6-7100-57 (9/71)

FILED June 16, 1986

BAKER COUNTY SURVEYOR

SURVEY NO. 8-44-82