


CERTIFIED RECORD OF LAND CORNER MONUMENTATION

History of original corner establishment:

None.

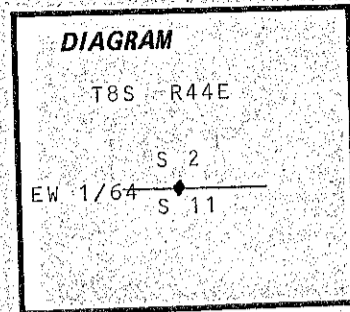

Description of corner evidence found:

None.

Description of monument and accessories established to perpetuate the original location of this corner:

Set 2"x30" alum. pipe with 3/4" alum. cap 27" in the ground. No stone available.

10" Ponderosa Pine S39°38'W, 53.6', mkd., "EW 1/64 S11 BT".


16" Ponderosa Pine N47°56'W, 57.3', mkd., "EW 1/64 S11 BT".

Set 6' steel post 10.5' N and 3' S with signs 54-9 and 54-2.

EACH BT has a 6" red painted band and face and brass LS washer and 54-9 and 54-3 signs.

N S fence 10' W.

Witnessed by L. David Brinton, LS #2065, and W. Kleiman.

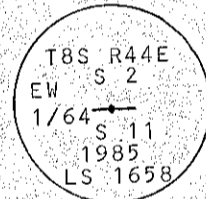

REGISTERED
PROFESSIONAL
LAND SURVEYOR

4-30-86

Ronald H. Schulson

OREGON
JULY 14, 1978
RONALD H. SCHULSON
1658

Office of..... County of Baker

State of....., I hereby certify that the within instrument was filed in this office

for record on the..... day of....., 19.....

..... by

(COUNTY OFFICIAL) (DEPUTY)

FILED June 16, 1986

BAKER COUNTY SURVEYOR

SURVEY # 8-44-85