


CERTIFIED RECORD OF LAND CORNER MONUMENTATION

History of original corner establishment:

None of record.

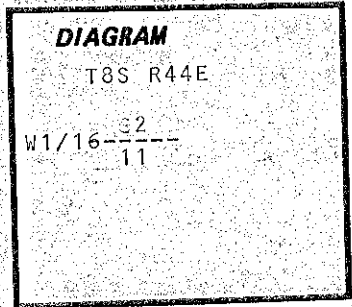


Description of corner evidence found:

I found an unrecorded basalt stone, 16"x11"x9" with no apparent marks, firmly planted and upright with one stone on North side from which a 29" Douglas Fir bears N04°E, 18.5 feet from said stone with an obvious closed face.
 Said stone bears S32°11'W, 8.1 feet from the true corner.

Description of monument and accessories I established to perpetuate the original location of this corner:

I set a 2"x30" Aluminum pipe with 3/4" aluminum cap 27" in the ground and marked as shown hereon.
 No. stone available.
 9" Ponderosa Pine, N80°30'W, 47.2 feet, marked "W 1/16 S2 BT".
 9" White Fir, S38°09'E, 68.9 feet, marked "W 1/16 S11 BT".
 6' steel fence posts 5' West and South with signs 54-9 & 54-2.
 Each BT has 6" red painted band and face and brass LS washer and signs 54-9 and 54-3.

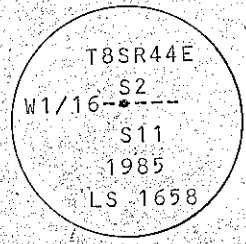

Witnessed by: J. David Brinton and W. Kleiman.

REGISTERED
 PROFESSIONAL
 LAND SURVEYOR

4-30-86
Ronald H. Schulson

OREGON
 JULY 14 1978
 RONALD H. SCHULSON
 1658

Office of..... County of..... Baker.....
 State of..... I hereby certify that the within instrument was filed in this office
 for record on the..... day of....., 19.....
 by
 (COUNTY OFFICIAL) (DEPUTY)