


CERTIFIED RECORD OF LAND CORNER MONUMENTATION

History of original corner establishment:

None.

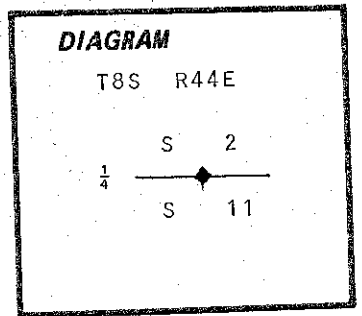

Description of corner evidence found:

None.

Description of monument and accessories I established to perpetuate the original location of this corner:

Set 2"x30" alum. pipe with 3 1/4" alum. cap 25" in the ground in a small mound of stone.

8" Ponderosa Pine N38°39'W, 102.7', mkd., "1/4 S2 BT".

12" Ponderosa Pine S22°29'W, 91.0', mkd., "1/4 S11 BT".


Set 6' steel post 3' N with 54-9 sign.

Each BT has a 6" red painted band and face and brass LS washer and 54-9 and 54-3 signs.

Remains of one lone fence jack is N approx. 125'.

Witnessed by J. David Brinton, LS #2065.

and W. Kleiman.

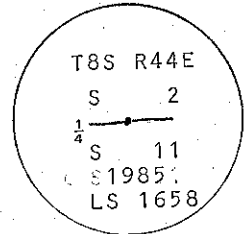

REGISTERED
PROFESSIONAL
LAND SURVEYOR

4-30-86

Ronald H. Schulson

OREGON
JULY 14, 1978
RONALD H. SCHULSON
1658

Office of..... County of Baker
State of....., I hereby certify that the within instrument was filed in this office
for record on the..... day of....., 19.....
..... by
(COUNTY OFFICIAL) (DEPUTY)

Form R6-7100-57 (9/71)

FILED June 16 1986 ☆ GPO-798-276

BAKER COUNTY SURVEYOR

SURVEY NO. 8-44-87