


CERTIFIED RECORD OF LAND CORNER MONUMENTATION

History of original corner establishment:

None orig. set.

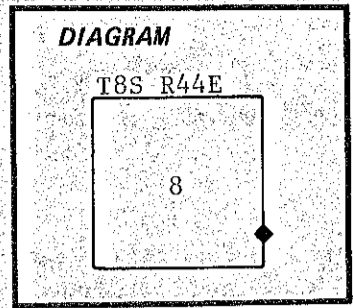


Description of corner evidence found:

None orig. set.

Description of monument and accessories I established to perpetuate the original location of this corner:

Set
 2"x30" Alum. pipe with 3-1/4" Alum. cap 27" in the ground.
 No stone available.
 10" P.P. N74° 30' W 29.7 ft., mkd. " S 1/16 S8 BT".
 6" P.P. S18° 36' E 26.3 ft., mkd. " S 1/16 S9 BT".
 Set 6' steel post 5' N. with 54-9 & 54-2 signs.

Witnessed by : J. David Brinton. 4/30/86

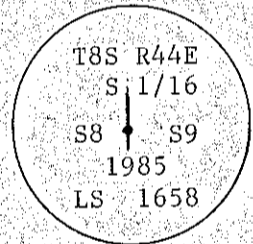

REGISTERED
 PROFESSIONAL
 LAND SURVEYOR
 4-30-86
Ronald H. Schulson
 OREGON
 JULY 14, 1973
 RONALD H. SCHULSON
 1658

Office of..... County of..... Baker.....

State of....., I hereby certify that the within instrument was filed in this office for record on the..... day of....., 19.....

(COUNTY OFFICIAL)

(DEPUTY)

FILED June 16 1986
 BAKER COUNTY SURVEYOR
 SURVEY NO. 8-44-89