


CERTIFIED RECORD OF LAND CORNER MONUMENTATION

History of original corner establishment:

Survey by Hoffman in 1914, set basalt stone 18"x12"x8" mkd. 1/16 on E. face.

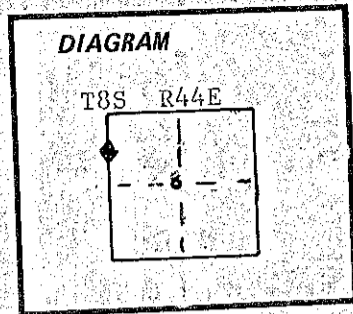

Description of corner evidence found:

Found stone 19"x14"x8" lying loose 4" South Westerly from corner position, marked 1/16.

Description of monument and accessories established to perpetuate the original location of this corner:

Set 2"x30" Alum. pipe with 3/4" Alum. cap 22" in ground and erected a mound of stone around pipe.

Placed Hoffman's stone in M.O.S. on S. side of pipe.

30" P.P., N 6° 01' W, 209.5 ft. mkd. " N1/16 S7 BT".


6" P.P., N17° 27' E, 323.2 ft. mkd. " N1/16 S8 BT".

Each with 6" painted red face & band & signs 54-9 & 54-3 & brass L.S. washers.

Set 6' steel post 3' N & 15'E, with 54-9 & 54-2 signs.

Witnessed by : W. Kleiman & D. Brinton, LS. # 2065.

P.P.= Ponderosa Pine

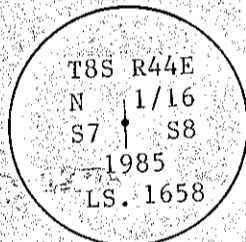

REGISTERED PROFESSIONAL LAND SURVEYOR

4-30-86

Ronald H. Schulson

OREGON
JULY 14, 1978
RONALD H. SCHULSON
1658

Office of..... County of Baker.....

State of..... I hereby certify that the within instrument was filed in this office

for record on the..... day of....., 19.....

..... by (DEPUTY)

(COUNTY OFFICIAL)

FILED June 16, 1986

BAKER COUNTY SURVEYOR

SURVEY NO. 8-44-90