


CERTIFIED RECORD OF LAND CORNER MONUMENTATION

History of original corner establishment:

Originally established by W. Barr in 1881.  
Set stone 14"x8"x6" and M.O.S.  
In 1914 Hoffman found basalt rock 4"x6"x14", mkd. 1/4 on E. face.

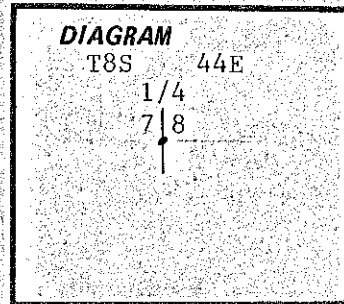


Description of corner evidence found:

I found basalt rock 14"x8"x6" lying in rock jack of fence corner jack of fence corner, fences running N & W. No marks.  
No positive proof this stone is the record one.

Description of monument and accessories I established to perpetuate the original location of this corner:

Set 2"x30" aluminum pipe with 3-1/4" alum. cap 26" in the ground at South side of anchor post. and in a mound of stone.  
No trees were available so I set the following :  
5/8"x30" I.R. with aluminum cap N 06° E, 13.47', marked "RM 13.47"  
5/8"x30" I.R. with aluminum cap S 88° 1/4° W, 13.22', marked "RM 13.22"  
with 6' steel fence posts and signs 54-9 and 54-3 set beside each RM.

Witnessed by : Steve Corbett

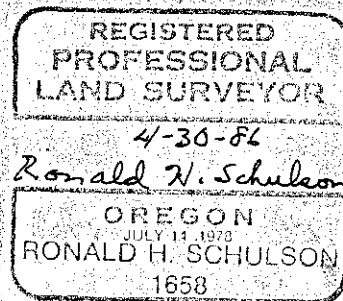

Office of..... County of..... Baker.....  
State of..... I hereby certify that the within instrument was filed in this office  
for record on the..... day of....., 19....  
..... by .....  
(COUNTY OFFICIAL) (DEPUTY)

FILED June 16, 1986  
BAKER COUNTY SURVEYOR  
SURVEY NO. 8-44-25