


CERTIFIED RECORD OF LAND CORNER MONUMENTATION

History of original corner establishment:

(Original GLO Survey in 1881 by W. Barr, set granite rock 12"x12"x8" and mound of rock).

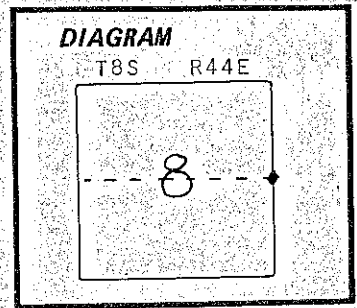

Description of corner evidence found:

I found no trace of said stone or mound.
 A fence corner exists at the approximate search position with fences running West and South. This fence has apparently been in existence at this location for many years and even though recently rebuilt remains of the old fence still exist to indicate that the present fence was rebuilt in substantially the same location. In addition to the fence we found several corners in the interior of section 8 which were set by Hoffman in 1914 when he claimed to have all the 1/4 corners and even though his survey was somewhat sloppy it still basically fits the fence position.

Description of monument and accessories I established to perpetuate the

original location of this corner: I accepted the above fence corner as the best remaining evidence of this corner and at said fence corner I:

Set 2"x30" alum. pipe with 3 1/4" alum. cap 24" in the ground and erected a small mound of stone around pipe.

6" Ponderosa Pine N16 1/2°W, 81.2', mkd., "1/4 S8 BT".

20" Ponderosa Pine N41°E, 71.8', mkd., "1/4 S8 BT".

Set 6' steel post 6' W and 4' S with signs 54-9 and 54-2.

Each BT has a 6" red painted band and face and brass LS washer and 54-9 and 54-3 signs.

Creek running SE 1s 57' N and 30' E.

Witnessed by P. Leigh and S Corbett.

T8S R44E
 S 8 1/4 S 9
 1985
 LS 1658

**REGISTERED
 PROFESSIONAL
 LAND SURVEYOR**

4-30-86
Ronald W. Schulson

OREGON
 JULY 14, 1975
RONALD H. SCHULSON
 1858

Office of..... County of Baker

State of....., I hereby certify that the within instrument was filed in this office for record on the..... day of....., 19.....

..... by
 (COUNTY OFFICIAL) (DEPUTY)

FILED June 16, 1986
 BAKER COUNTY SURVEYOR
 SURVEY NO. 8-44-96