


CERTIFIED RECORD OF LAND CORNER MONUMENTATION

History of original corner establishment:

Originally established by W. Barr in 1881.
Set basalt rock 12"x10"x8" & rock mound.
Hoffman in 1914 found quartz stone, 10"x6"x4" at fence corner.
In 1924, Collins found marked stone at fence corner.

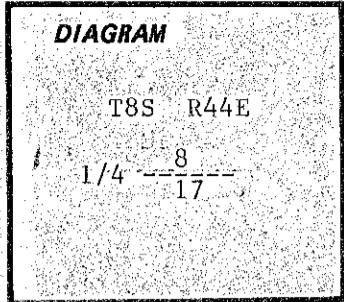

Description of corner evidence found:

I found a stone, 14"x7"x5" with faint marks which appears to "1/4" lying disturbed near the fence corner.

No original BT'S were set.


Description of monument and accessories I established to perpetuate the original location of this corner:

Set 2"x30" aluminum pipe with 2-1/4" aluminum cap 24" in the ground in mound of stone, On the North side of the fence corner Rock Jack with fences running West and South & traces of an old downed fence to the East. I placed the stone with the possible marks in the mound of stone.

No trees were available so I set the following:
A 5/8"x30" iron rod with aluminum cap, N86°07'W, 9.98 feet, marked, "RM 9.98";
A 5/8"x30" iron rod with aluminum cap, S13°25'E, 11.20 feet, marked, "RM 11.20".
The Aluminum Pipe is marked as shown hereon.

Witnessed by: Pat Leigh and S. Corbett.

A 6' steel fence with signs 54-9 and 54-3 is set beside each RM.

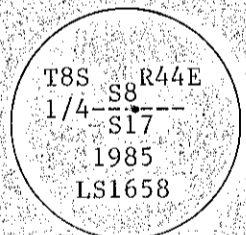

REGISTERED
PROFESSIONAL
LAND SURVEYOR

4-30-8C
Ronald W. Schulson

OREGON
JULY 14, 1979
RONALD H. SCHULSON
1658

Office of..... County of..... Baker.....
State of..... I hereby certify that the within instrument was filed in this office
for record on the..... day of....., 19.....
..... by
(COUNTY OFFICIAL) (DEPUTY)

FILED June 16, 1986
BAKER COUNTY SURVEYOR
SURVEY NO. 8-44-97