


CERTIFIED RECORD OF LAND CORNER MONUMENTATION

History of original corner establishment:

Original GLO Survey by W. Barr in 1881
Set stake 4'x4", 18" deep & Rock mound.

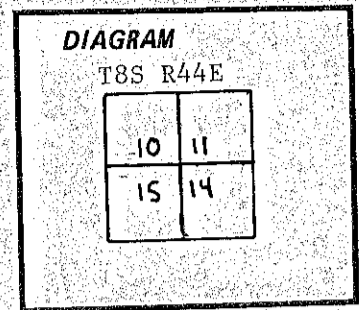

Description of corner evidence found:

None

Description of monument and accessories | established to perpetuate the original location of this corner:

Set 2" ^{x30"} Aluminum Pipe with 3 1/4" Aluminum cap 23" in the ground in a mound of stone.

17" Ponderosa Pine, North 60° 57' West, 506.3 ft. marked "T8SR44ES10BT".


5/8"x30" Iron rod with Aluminum Cap, South 89° 35' West, 10.00 ft. mkd. "RM10.00".

5/8"x30" Iron rod with Aluminum Cap, South 00° 25' East, 10.00 feet, mkd. "RM10.00".

Set 6' steel post 6" from each RM, with signs 54-9 & 54-3.

BT has 6" red painted face & band & brass LS. washer & signs 54-9 & 54-3.

Witnessed by : W. Kleiman

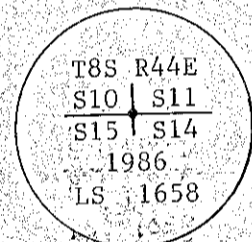

REGISTERED
PROFESSIONAL
LAND SURVEYOR

5-30-86

Ronald H. Schulson

OREGON
JULY 14, 1978
RONALD H. SCHULSON
1658

Office of..... County of Baker

State of..... I hereby certify that the within instrument was filed in this office for record on the..... day of....., 19.....

..... by..... (DEPUTY)

(COUNTY OFFICIAL)

FILED June 16 1986
BAKER COUNTY SURVEYOR
SURVEY NO. 8-44-98