


CERTIFIED RECORD OF LAND CORNER MONUMENTATION

History of original corner establishment:

None.
No evidence found.

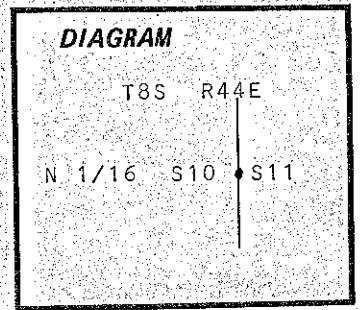


Description of corner evidence found:

None.

Description of monument and accessories I established to perpetuate the original location of this corner:

Set 2"x30" alum. pipe with 3/4" alum. cap 24" in the ground in a small mound of stone.
 9" P.P. S26°48'W, 76.3', mkd., "N 1/16 S10 BT".
 16" P.P. S58°30'E, 106.1', mkd., "N 1/16 S11 BT".
 Set 6' steel post 8.8' N and 5' west with signs 54-9 and 54-2.
 Each BT has red painted band and face and brass LS washer and 54-9 and 54-3 signs.
 Witnessed by J. David Brinton, LS #2065.

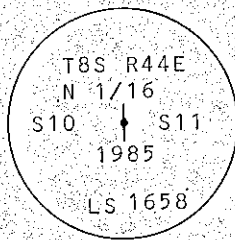

**REGISTERED
PROFESSIONAL
LAND SURVEYOR**
 4-30-86
Ronald W. Schulson
OREGON
JULY 14, 1978
RONALD H. SCHULSON
 1658

Office of..... County of..... Baker
 State of....., I hereby certify that the within instrument was filed in this office
 for record on the..... day of.....; 19.....
 by
 (COUNTY OFFICIAL) (DEPUTY)

FILED June 16 1986
 BAKER COUNTY SURVEYOR
 SURVEY NO. 8-44-99