


CERTIFIED RECORD OF LAND CORNER MONUMENTATION

History of original corner establishment:

None found.

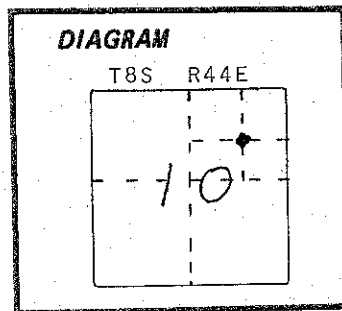


Description of corner evidence found:

None.

Description of monument and accessories established to perpetuate the original location of this corner:

Set 2"x30" alum. pipe with 3/4" alum. cap 28" in the ground in a collar of stone.  
 9" Ponderosa Pine N88°23'W, 28.9', mkd., "NE 1/16 S10 BT".  
 8" Ponderosa Pine S08°E, 22.4', mkd., "NE 1/16 S10 BT".  
 Set 6' steel post 13' E and 5' S with 54-9 and 54-2 signs.  
 Each BT has a 6" red painted band and face and brass LS washer and signs 54-9 and 54-3.  
 Fence corner 13' S44°E, fences running E-W.  
 Witnessed by J. David Brinton, LS #2065.

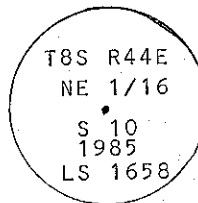

**REGISTERED  
PROFESSIONAL  
LAND SURVEYOR**

4-30-86

*Ronald H. Schulson*

**OREGON**  
JULY 14, 1978  
**RONALD H. SCHULSON**  
 1658

Office of..... County of... Baker.....

State of....., I hereby certify that the within instrument was filed in this office

for record on the..... day of....., 19.....

..... by .....

(COUNTY OFFICIAL)

(DEPUTY)

Form R6-7100-57 (9/71)

FILED June 16, 1986  
26FO-198-276  
 BAKER COUNTY SURVEYOR  
 SURVEY NO. 8-44-101