


CERTIFIED RECORD OF LAND CORNER MONUMENTATION

**History of original corner establishment:**

Original GLO survey by W. Barr in 1881, set a basalt rock, 12"x10"x6" in a mound of stone.

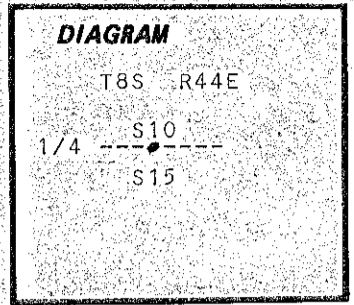

**Description of corner evidence found:**

No trace could be found of the original stone or mound but I did find a 5/8" iron rod with plastic cap marked "LS 645", 4.20 feet, N88°57'E. No record of such.

**Description of monument and accessories I established to perpetuate the original location of this corner:**

Set 2"x30" Aluminum pipe with 3 1/4" aluminum cap, 26" in the ground and in a mound of stone, and following BT's:


14" Ponderosa Pine, N06°19'E, 81.5 feet, marked, "1/4 S10 BT";

18" Ponderosa Pine, S82°14'E, 44.4 feet, marked, "1/4 S15 BT".

Each BT has 6" red painted band and face and brass LS washer and signs 54-9 and 54-3.

Set 6' steel fence post 2 feet East with sign 54-9, S15

Witnessed by: J. David Brinton and W. Kleiman.

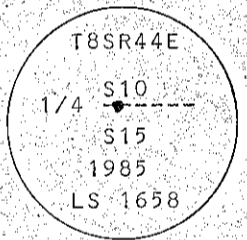

REGISTERED  
PROFESSIONAL  
LAND SURVEYOR

4-30-86

*Ronald H. Schulson*

OREGON  
JULY 14, 1978  
RONALD H. SCHULSON  
1658

Office of..... County of..... Baker.....

State of..... I hereby certify that the within instrument was filed in this office

for record on the..... day of....., 19.....

..... by .....

(COUNTY OFFICIAL)

(DEPUTY)