


CERTIFIED RECORD OF LAND CORNER MONUMENTATION

History of original corner establishment:

(Original GLO in 1881 by W. Barr set stone 18"x14"x8" and 2 BT's).
 (.18" Pine N48°E, .20 Chains).
 (.18" Pine S53°W, .28 chains).

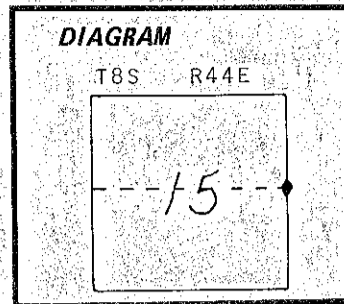


Description of corner evidence found:

I find a 2" iron pipe with 2½" brass cap 6" high in small mound of stone, also a steel fence post with sign S30°W, 1.7'.
 26" Ponderosa Pine stump N37°45'E, 18.7'.
 20" Ponderosa Pine stump S47°45'W, 17.6'.
 No marks, face area rotted away on both stumps.
 These could be original, but no better evidence to prove it.

Description of monument and accessories I established to perpetuate the original location of this corner:

13" Douglas Fir N20°E, 49.3', mkd., "¼ S14 BT".
 8" Ponderosa Pine S69°W, 9.1', mkd., "¼ S15 BT".
 Each BT has a 6" red painted band and face and brass LS washer and signs 54-9 and 54-3.

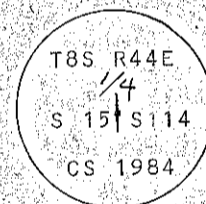

**REGISTERED
 PROFESSIONAL
 LAND SURVEYOR**

4-30-86

Ronald H. Schulson

OREGON
 JULY 14 1978
RONALD H. SCHULSON
 1658

Office of..... County of Baker
 State of..... I hereby certify that the within instrument was filed in this office
 for record on the..... day of....., 19.....
 by
 (COUNTY OFFICIAL) (DEPUTY)

FILED June 16, 1986
 BAKER COUNTY SURVEYOR
 SURVEY NO. 8-44-106