


CERTIFIED RECORD OF LAND CORNER MONUMENTATION

History of original corner establishment:

NONE

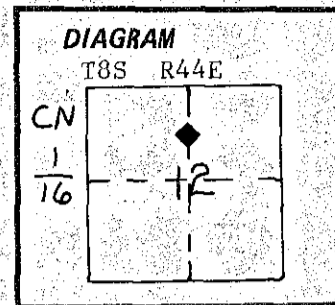


Description of corner evidence found:

NONE

Description of monument and accessories I established to perpetuate the original location of this corner:

SET 2"x30" Aluminum pipe with 3 1/4" Aluminum cap.
 20" in the ground & in a mound of stone.
 13" Ponderosa Pine, S03°45'W, 45.8 feet, Marked "CN 1/16 S12 BT".
 9" Ponderosa Pine, (Easterly of double tree) N53°12'W, 18.1 feet,
 Each with 6" red painted band & face & brass LS washer and signs 54-9 &
 54-3.
 6' steel post 5 feet East & North with signs 54-9 & 54-2.
 9" BT is marked "CN 1/16 S12 BT".
 Witnessed by: R.J. Schulson
 B. Haynes

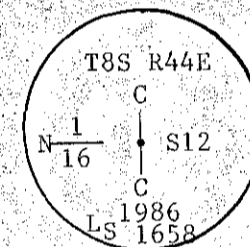

REGISTERED
 PROFESSIONAL
 LAND SURVEYOR
 7-26-86
Ronald H. Schulson
 OREGON
 JULY 14, 1978
 RONALD H. SCHULSON
 1658

Office of..... County of Baker
 State of....., I hereby certify that the within instrument was filed in this office
 for record on the..... day of....., 19.....
 by.....
 (COUNTY OFFICIAL) (DEPUTY)

FILED July 31, 1986
 BAKER COUNTY SURVEYOR
 SURVEY NO. B-44-116