


CERTIFIED RECORD OF LAND CORNER MONUMENTATION

History of original corner establishment:
NONE

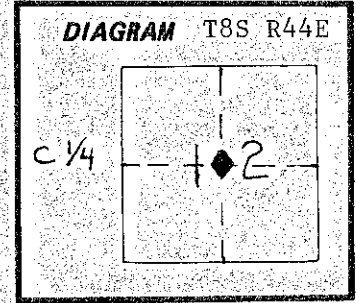

Description of corner evidence found:
NONE

Description of monument and accessories established to perpetuate the original location of this corner:

T8S R44E
C 1/4 S12
1986
LS 1658

SET: 2" Aluminum Pipe with 3-1/4" Al. cap 14" in the ground and in a mound of stone, cap marked as shown, and:
14" Ponderosa Pine, N01°14'W, 283.6 feet, marked, "C1/4 S12 BT", signs 54-9 & 54-3.
"+" on firmly planted basalt boulder rock, 3'x3'x1.5' high, N48°14'E, 280.1 feet, with signs 54-9 and 54-3.
6' steel post set 0.5 feet SW with sign 54-9.
Witnessed by: B. Haynes.

Each BT has has 6" red painted band & face & brass LD washer.

REGISTERED
PROFESSIONAL
LAND SURVEYOR

7-25-86

Ronald H. Schulson

OREGON
JULY 14, 1978
RONALD H. SCHULSON
1658

Office of..... County of Baker
State of....., I hereby certify that the within instrument was filed in this office
for record on the..... day of....., 19.....
..... by
(COUNTY OFFICIAL) (DEPUTY)

FILED July 31, 1986
BAKER COUNTY SURVEYOR
SURVEY NO. 8-44-117