


CERTIFIED RECORD OF LAND CORNER MONUMENTATION

History of original corner establishment:

NONE

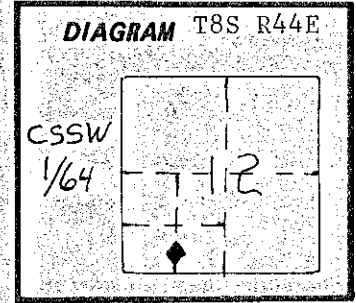

Description of corner evidence found:

NONE

Description of monument and accessories established to perpetuate the original location of this corner:

SET: 2"x30" Aluminum Pipe with 3-1/4" Alum. cap 10" in the ground and in a mound of stone, cap marked as shown, and:

5/8"x30" Iron rod in stone mound N89°10'E, 125.14 feet, marked "RM 125.14-->"

"+" on top of imbedded basalt rock, 4'x3'x1' high, S00°17'E, 124.75 feet.

6' steel post with 54-9 and 54-2 signs, 4' East and 14' South.

6' steel post with 54-9, 54-3 and 54-2 signs in mound of stone 3' South of "+" on rock.

Witnessed by: R.J. Schulson  
B. Haynes

T8S R44E  
 CSSW  
 1/64 • 512  
 1986  
 LS 1658

REGISTERED  
 PROFESSIONAL  
 LAND SURVEYOR

7-25-86

Ronald N. Schulson

OREGON  
 JULY 14, 1978  
 RONALD H. SCHULSON  
 1658

Office of..... County of..... Baker

State of..... I hereby certify that the within instrument was filed in this office

for record on the..... day of....., 19.....

..... by.....  
(COUNTY OFFICIAL) (DEPUTY)

FILED July 31, 1986  
 BAKER COUNTY SURVEYOR  
 SURVEY NO. 8-44-119