


CERTIFIED RECORD OF LAND CORNER MONUMENTATION

History of original corner establishment:

NONE

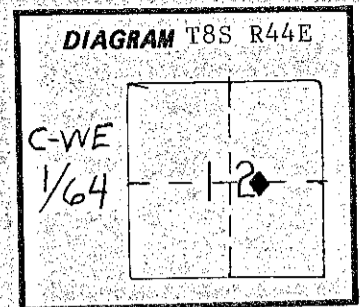

Description of corner evidence found:

NONE

Description of monument and accessories established to perpetuate the original location of this corner:

SET: 2"x30" Aluminum Pipe with 3-1/4" Alum. cap 20" in the ground and in a mound of stone, cap marked as shown, and:
17" Ponderosa Pine, S05°17"W, 357.9 feet, Marked, "CWE 1/64 S12 BT", signs 54-9 and 54-3.

"+" on top of firmly implanted basalt boulder rock 2.5'x2'x1.5' high, S66°57'E, 19.02 feet, with signs 54-9 and 54-3 beside.

6' steel post set 5 feet North with signs 54-2 and 54-9.

Witnessed by: B. Haynes.

Each BT has 6" red painted band & face & brass LS washer.

T8S R44E
CWE 1/64 • S12
1986
LS 1658

REGISTERED
PROFESSIONAL
LAND SURVEYOR
7-25-86

Ronald N. Schulson

OREGON
JULY 14, 1978
RONALD H. SCHULSON
1658

Office of..... County of..... Baker

State of....., I hereby certify that the within instrument was filed in this office
for record on the..... day of....., 19.....

..... by.....

(COUNTY OFFICIAL)

(DEPUTY)

Form R6-7100-57 (9/71)

GPO-798-276

FILED July 31, 1986
BAKER COUNTY SURVEYOR
SURVEY NO. 8-4A-122