


CERTIFIED RECORD OF LAND CORNER MONUMENTATION

History of original corner establishment:

Original GLO survey by W. Barr in 1881, set Basalt rock, 12"x10"x6" in a rock mound.

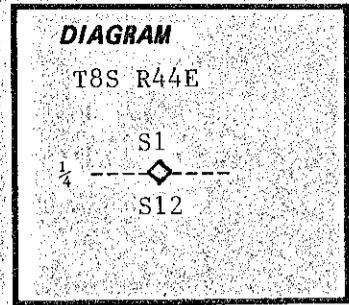


Description of corner evidence found:

I find no trace of said monument.

Description of monument and accessories I established to perpetuate the original location of this corner:

At the single proportion position I set a 2"x30" Aluminum Pipe with 3 1/4" Aluminum cap marked as shown hereon, 16" in the ground and in a Mound of Stone from which bear the following:
 5/8"x30" iron rod with Aluminum cap, S01°22'E, 478.18 feet, marked: "RM 478.18 --->".
 "+" on top of Basalt rock outcrop, 5'x2.5'x1.5' high, N38°16'E, 16.7 feet.
 "+" on top of Basalt rock outcrop, 4'x3'x10" high, S62°59'E, 22.1 feet.
 Set 6' steel posts 3' South & 9' West with signs 54-9 & 54-2.
 Signs 54-9 & 54-3 by each RM.

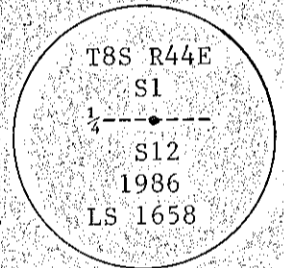

Witnessed by: R.J. Schulson
B. Haynes

REGISTERED
PROFESSIONAL
LAND SURVEYOR
7-26-86
Ronald H. Schulson
OREGON
JULY 14 1978
RONALD H. SCHULSON
1658

Office of..... County of..... Baker
 State of....., I hereby certify that the within instrument was filed in this office
 for record on the..... day of....., 19....
 by
 (COUNTY OFFICIAL) (DEPUTY)

FILED July 31, 1986
 BAKER COUNTY SURVEYOR
 SURVEY NO. 8-44-124