


CERTIFIED RECORD OF LAND CORNER MONUMENTATION

History of original corner establishment:

NONE

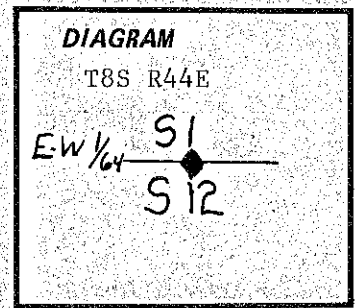


Description of corner evidence found:

NONE

Description of monument and accessories established to perpetuate the original location of this corner:

- Set 2"x30" Aluminum pipe with 3 1/4" Aluminum cap.
- 25" in the ground in small mound of stone.
- 5/8"x30" Iron rod, N02°20'E, 82.36 feet, marked "RM 82.36 -->".
- 5/8"x30" Iron rod, N88°17'E, 50.23 feet, marked "RM 50.23 -->".
- Set 6' steel posts within 0.5' of each RM with signs 54-9, 54-2, 54-3.
- Set 6' steel posts 3' North & East of corner with signs 54-9 & 54-2.

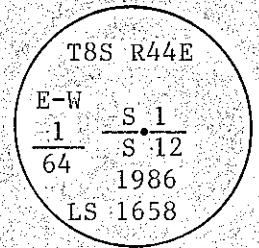

Witnessed by: R. J. Schulson  
B. Haynes

REGISTERED  
PROFESSIONAL  
LAND SURVEYOR  
7-10-86  
*Ronald H. Schulson*  
OREGON  
JULY 14 1978  
RONALD H. SCHULSON  
1658

Office of..... County of... Baker.....  
 State of..... I hereby certify that the within instrument was filed in this office  
 for record on the..... day of....., 19.....  
 by.....  
 (COUNTY OFFICIAL) (DEPUTY)

FILED July 31, 1986  
 BAKER COUNTY SURVEYOR  
 SURVEY NO. 8-44-125