


CERTIFIED RECORD OF LAND CORNER MONUMENTATION

History of original corner establishment:

NONE

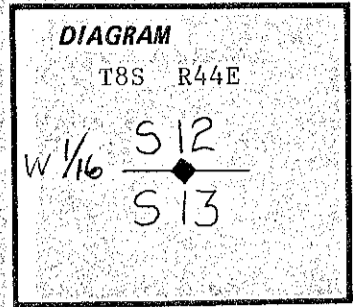


Description of corner evidence found:

NONE

Description of monument and accessories established to perpetuate the original location of this corner:

- SET 2"x30" Aluminum pipe with 3 1/4" Aluminum cap.
- 15" in the ground & in mound of stone.
- 5/8"x30" Iron rod with Aluminum Cap, N00°55'W, 16.72 feet, marked "RM 16.72 -->".
- 5/8"x30" Iron rod with Aluminum cap, N89°20'E, 21.54 feet, marked "RM 21.54 -->".
- Set 6' steel posts with 54-2, 54-3 signs 6" from each RM.
- Set 6' steel post 3' South with 54-9 sign.

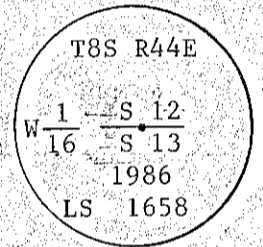

Witnessed by: B. Haynes
R.J. Schulson

REGISTERED
PROFESSIONAL
LAND SURVEYOR

7-10-86
Ronald H. Schulson

OREGON
JULY 14, 1978
RONALD H. SCHULSON
1658

Office of..... County of..... Baker.....

State of....., I hereby certify that the within instrument was filed in this office
for record on the..... day of....., 19.....

..... by
(COUNTY OFFICIAL) (DEPUTY)

FILED July 31, 1986
BAKER COUNTY SURVEYOR
SURVEY NO. B-44-178