


CERTIFIED RECORD OF LAND CORNER MONUMENTATION

History of original corner establishment:

NONE

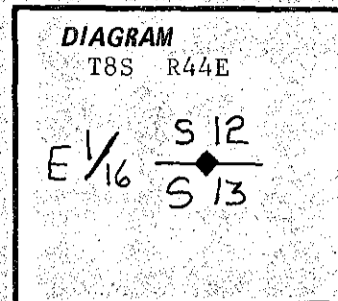


Description of corner evidence found:

NONE

Description of monument and accessories established to perpetuate the original location of this corner:

SET 2"x30" Aluminum pipe with 3/4" Aluminum cap.
 8" in the ground and in a large mound of stone.
 6'x10'x4' high Rock outcrop N36°53'W, 114.8 feet, marked "+ B0". on 1 foot square smooth surface on SE face of Rock.
 5/8"x30" Iron rod with aluminum cap, N89°20'E, 41.36 feet, marked "RM 41.36 -->".
 Set 6' steel post with signs 54-9 & 54-2, 5' West.

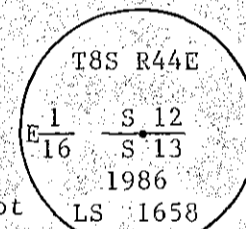

Witnessed by: R.J. Schulson
B. Haynes

REGISTERED
PROFESSIONAL
LAND SURVEYOR

7-10-86

Ronald H. Schulson

OREGON
JULY 14, 1978
RONALD H. SCHULSON
1658

Office of..... County of Baker.....

State of....., I hereby certify that the within instrument was filed in this office for record on the..... day of....., 19.....

..... by
(COUNTY OFFICIAL) (DEPUTY)