


CERTIFIED RECORD OF LAND CORNER MONUMENTATION

History of original corner establishment:

None.

A stone mound 5' x 5' x 5' N 05° E, 23.5' bare ground.

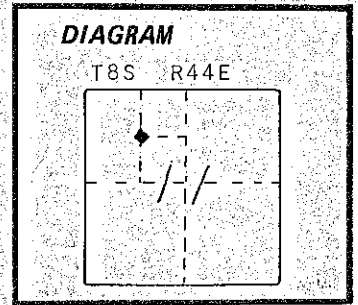

Description of corner evidence found:

Found a stone mound which appears to have been meant for a survey monument which I could find no record of. N 05° E, 23.5 feet.

Description of monument and accessories I established to perpetuate the original location of this corner:

Set 2"x30" alum. pipe with 3 1/4" alum. cap 27" in the ground in a small mound of stone.

11" Ponderosa Pine N0°08'E, 62.7', mkd., "NW 1/16 S11 BT".

13" Ponderosa Pine N40°51'E, 56.9', mkd., "NW 1/16 S11 BT".

Set 6' steel post 5' N and 8.4' E with signs 54-9 and 54-2.

Each BT has a 6" red painted band and face and brass LS washer and 54-9 and 54-3 signs.

Witnessed by J. David Brinton, LS #2065, & W. Kleiman.

Corner is 3' W of remains of fence running N-S and 15' S of remains of old fence running E.

T8S R44E
 NW 1/16
 S 11
 1985
 LS 1658

REGISTERED
 PROFESSIONAL
 LAND SURVEYOR
 4-30-86
Ronald H. Schulson
 OREGON
 JULY 14, 1978
 RONALD H. SCHULSON
 1658

Office of..... County of..... Baker

State of....., I hereby certify that the within instrument was filed in this office for record on the..... day of....., 19.....

..... by
 (COUNTY OFFICIAL) (DEPUTY)

FILED July 31, 1986
 BAKER COUNTY SURVEYOR
 SURVEY NO. 8-44-130