


CERTIFIED RECORD OF LAND CORNER MONUMENTATION

History of original corner establishment:

Original survey by W. Barr in 1881, set basalt rock, 12"x9"x8" in mound of rock.

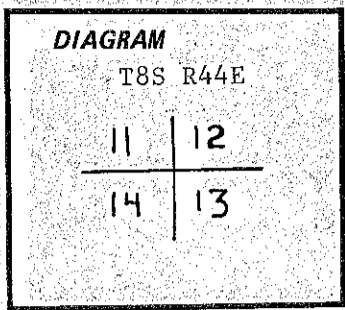


Description of corner evidence found:

NO trace could be found.

Description of monument and accessories established to perpetuate the original location of this corner:

At the Double Proportion position, I set 2"x30" aluminum pipe with 3-1/4" aluminum cap as shown hereon, 17" in ground and in mound of stone, and the following:  
 Mound of stone, S36°31'W, 16.5 feet, 4' base, with signs 54-3 & 54-9.  
 Mound of stone, S66°48'E, 18.0 feet, 4' base, with signs 54-3 & 54-9.  
 + On top of basalt rock 3'x3'x2' high, N36°31'E, 8.12 feet, beside which I set 6' steel post with 54-9 & 54-3 signs.  
 + On top of basalt rock 2½'x2½'x8" high, N66°48'W, 21.4 feet, beside which I set 6' steel post with signs 54-9 & 54-3.  
 Set 6' steel post 3 feet South with sign 54-9.

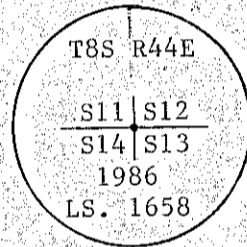

Witness by: R. J. Schulson  
 B. Haynes

REGISTERED  
 PROFESSIONAL  
 LAND SURVEYOR

6-30-86  
*Ronald W. Schulson*

OREGON  
 JULY 14, 1978  
 RONALD H. SCHULSON  
 1658

Office of..... County of..... Baker  
 State of....., I hereby certify that the within instrument was filed in this office  
 for record on the..... day of....., 19.....  
 ..... by .....  
 (COUNTY OFFICIAL) (DEPUTY)