


CERTIFIED RECORD OF LAND CORNER MONUMENTATION

History of original corner establishment:

Originally established by W. Barr in 1881.
Set Lava Rock, 12"x8"x7" in mound of stone.

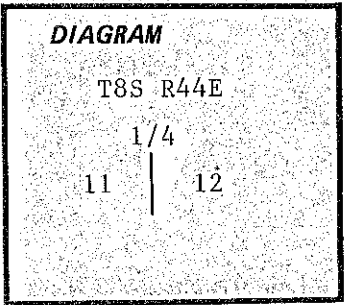


Description of corner evidence found:

I found said lava rock, 12"x8"x7" with marks 1/4 on the East face, firmly planted in a small mound of stones. Mound and stone were almost totally buried with dirt.

Description of monument and accessories I established to perpetuate the original location of this corner:

I set a 2"x30" Aluminum pipe with 3 1/4" alum. cap 24" in the ground and erected a stone mound around the pipe. I buried the original stone along the West side of the pipe.

No trees were available so I set the following RM's:
5/8"x30" iron rod with alum. cap, N89°32'E, 39.91 feet, marked, "RM 39.91 --->.
5/8"x30" iron rod with alum. cap, S89°32'W, 40.00 feet, marked, "RM 40.00 --->.

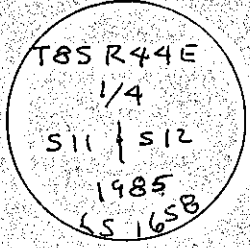

Witnessed by: P. Leigh and S. Corbett.

The aluminum cap is marked as shown hereon.

Set 6' steel fence post with sign 54-9, S60°W, 3 feet and 6' steel fence posts beside each RM with signs 54-9 & 54-3.

**REGISTERED
PROFESSIONAL
LAND SURVEYOR**

4-30-86
Ronald H. Schulson

OREGON
JULY 14, 1978
RONALD H. SCHULSON
1658

Office of..... County of..... Baker.....
State of..... I hereby certify that the within instrument was filed in this office
for record on the..... day of....., 19.....

..... by
(COUNTY OFFICIAL) (DEPUTY)

FILED July 31, 1986
BAKER COUNTY SURVEYOR
SURVEY NO. 8-44-134