


CERTIFIED RECORD OF LAND CORNER MONUMENTATION

History of original corner establishment:

NONE

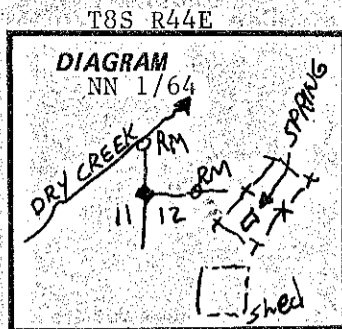

Description of corner evidence found:

NONE

Description of monument and accessories I established to perpetuate the original location of this corner:

- Set 2"x30" aluminum pipe with 3/4" aluminum cap, 24" in the ground in a mound of stone, and the following:
- 5/8"x30" iron rod with aluminum cap, N00°08'E, 13.27 feet, marked "RM 13.27 -->".
- 5/8"x30" iron rod with aluminum cap, N88°23'E, 12.17 feet, marked "RM 12.17 -->".
- Set 6' steel post 0.5 from each RM with signs 54-3, 54-2, & 54-9.
- Set 6' steel post 2' north of corner, with signs 54-9 & 54-2.

T8SR44E  
 NN 1/64  
 S11 + S12  
 1986  
 LS. 1658

Witnessed by: R. J. Schulson  
B. Haynes

REGISTERED  
 PROFESSIONAL  
 LAND SURVEYOR  
 6-30-86  
*Ronald H. Schulson*  
 OREGON  
 JULY 14, 1978  
 RONALD H. SCHULSON  
 1658

Office of..... County of Baker.....  
 State of..... I hereby certify that the within instrument was filed in this office  
 for record on the..... day of....., 19.....  
 ..... by .....  
 (COUNTY OFFICIAL) (DEPUTY)

FILED July 31, 1986  
 BAKER COUNTY SURVEYOR  
 SURVEY NO. 8-44-135