


CERTIFIED RECORD OF LAND CORNER MONUMENTATION

History of original corner establishment:

None.

Found possible stone mound N68°W, 28.7', no marks found on stone.

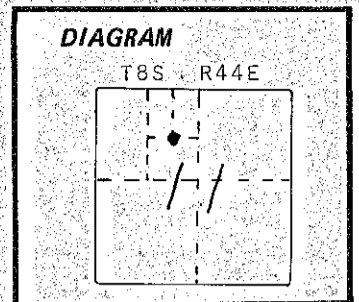

Description of corner evidence found:

None.

Description of monument and accessories established to perpetuate the original location of this corner:

Set 2"x30" alum pipe with 3 1/4" alum. cap 24" in the ground in a small mound of stone.  
 13" Ponderosa Pine N74°19'W, 313.0', mkd., "CENW 1/64 BT".  
 19" Ponderosa Pine N06°46'W, 266.0', mkd., "CENW 1/64 BT".  
 Set 6' steel post 3' W and 12' N with 54-9 and 54-2 signs.  
 Each BT has a 6" red painted band and face and brass LS washer and signs 54-9 and 54-3.

T8S R44E  
 CENW 1/64  
 S 11  
 1985  
 LS 1658

REGISTERED  
 PROFESSIONAL  
 LAND SURVEYOR  
 4-30-86  
*Ronald H. Schulson*  
 OREGON  
 JULY 14, 1978  
 RONALD H. SCHULSON  
 1658

Office of..... County of Baker.....  
 State of....., I hereby certify that the within instrument was filed in this office  
 for record on the..... day of....., 19.....  
 ..... by .....  
 (COUNTY OFFICIAL) (DEPUTY)

FILED July 31, 1986  
 BAKER COUNTY SURVEYOR  
 SURVEY NO. 8-44-136