


CERTIFIED RECORD OF LAND CORNER MONUMENTATION

History of original corner establishment:

Original GLO survey in 1881 by W. Barr, set lava rock 28"x16"x14" in mound of rock.

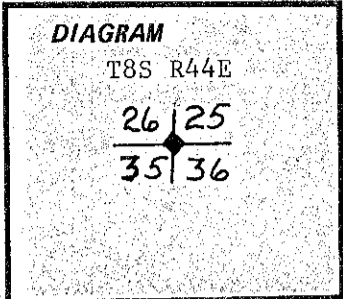


Description of corner evidence found:

Found lava rock 27"x16"x14" with 1 notch on South and 1 notch on East lying on side in rocks which could have been small mound.

Description of monument and accessories | established to perpetuate the

original location of this corner: In place of said stone I set a 2"x30" Aluminum pipe with 3-1/4" Alum. cap 15" in the ground in a mound of stone, and:
 Mound of stone with 4' base, S38°E, 9.2 feet, with signs 54-9 & 54-3.
 Mound of stone with 4' base, N38°W, 8.7 feet, with signs 54-9 & 54-3.
 Mound of stone with 4' base, S46°W, 9.4 feet, with signs 54-9 & 54-3.
 Mound of stone with 4' base, N46°E, 10.5 feet, with signs 54-9 & 54-3.
 Set 6' steel fence post 2.3 feet South.
 Variation 19½°E.
 Witness by: W. Kleiman

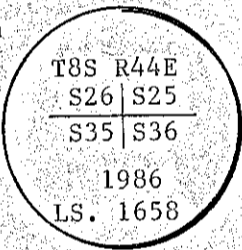

REGISTERED
 PROFESSIONAL
 LAND SURVEYOR

6-30-86
Ronald H. Schulson

OREGON
 JULY 14 1978
 RONALD H. SCHULSON
 1658

Office of..... County of Baker.....
 State of....., I hereby certify that the within instrument was filed in this office
 for record on the..... day of....., 19.....
 by
 (COUNTY OFFICIAL) (DEPUTY)

FILED July 31, 1986
 BAKER COUNTY SURVEYOR
 SURVEY NO. 8-44-137