

CERTIFIED RECORD OF LAND CORNER MONUMENTATION

History of original corner establishment:

Original survey by W. Barr in 1881, set basalt 12"x9"x6".
In 1914 Ira Hoffman finds what he calls a "Blue stone,
12"x8"x4" marked 1/4 in mound of stone.

DIAGRAM
T8S R44E
14
1/4 —————— 23

Description of corner evidence found:


I find a bluish stone 12"x8"x5" at an old down fence corner
lying among other stones but with marks "1/4" plainly visible.
Also found an unrecorded 1" iron pipe with 2½" brass cap, 7" high
with stone 12"x9"x6" buried along North side. Some marks are
visible on this stone but I do not believe them to be 1/4, said
iron pipe bears N78°15'41"W, 48.90 feet from the Blue stone.
Said iron pipe is stamped by the county surveyor as shown hereon.
Said "Blue stone" is S25°06'22"W, 5831.91 feet from the section
corner common to sections 11, 12, 13 and 14 as monumented in
June 1986.

Description of monument and accessories I established to perpetuate the
original location of this corner:

Set hub and tack beneath blue stone.
I set no witness objects but another iron pipe by the County
Surveyor with brass cap marked "1/4 S 13 CS 1980" bears
S 24
N89°51'08"E, 5184.14 feet.

Witness by: W. Kleiman.

T8S R44E
1/4 —————— S14
S 23
CS 1980

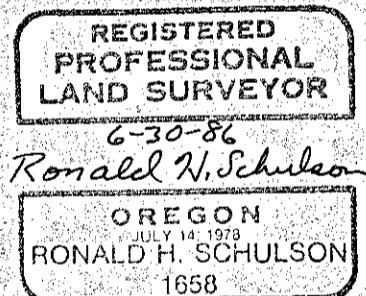

Office of..... County of..... Baker.....

State of....., I hereby certify that the within instrument was filed in this office
for record on the..... day of....., 19.....

..... by
(COUNTY OFFICIAL) (DEPUTY)