


CERTIFIED RECORD OF LAND CORNER MONUMENTATION

History of original corner establishment:

NONE

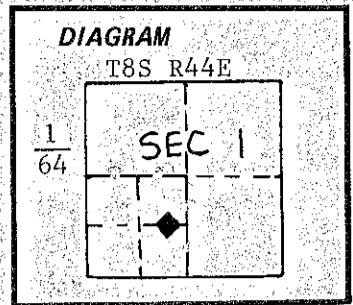


Description of corner evidence found:

NONE

Description of monument and accessories I established to perpetuate the original location of this corner:

- Set 3 1/2"x30" Aluminum pipe with 3 1/4" Aluminum cap.
- 21" in ground in mound of stone.
- 8" Douglas Fir, S74°30'E, 31.6 feet, marked "CESW 1/64".
- 6" Douglas Fir, S00°58'E, 2.8 feet, marked "CESW 1/64".
- Each BT with 6" red painted band & face, brass LS washer and signs 54-9 & 54-3.
- 6' steel post with signs 54-2 & 54-9, 5' South & West.

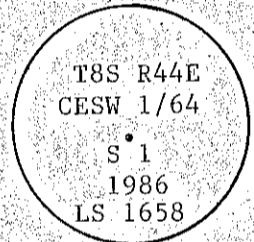

Witnessed by: R. J. Schulson
B. Haynes

**REGISTERED
PROFESSIONAL
LAND SURVEYOR**
 7-10-86
Ronald H. Schulson
OREGON
JULY 14, 1978
RONALD H. SCHULSON
 1658

Office of..... County of Baker
 State of..... I hereby certify that the within instrument was filed in this office
 for record on the..... day of....., 19.....
 by
 (COUNTY OFFICIAL) (DEPUTY)

FILED July 31, 1986
 BAKER COUNTY SURVEYOR
 SURVEY NO. 8-44-142