

CERTIFIED RECORD OF LAND CORNER MONUMENTATION

History of original corner establishment:

Original corner established by Nicholas O. Walden, under Contract No. 198, dated June 1, 1874.

Record states:

Set quartz rock, 10x9x9 ins., 5 ins. in the ground.

Corner reestablished by Carl E. Sundet, LS 1664, during survey filed with the Baker County Surveyor, file No. 8-44-63.


Record states:

Set a 2 1/2 ins. x 30 ins. long aluminum pipe with 3 1/4 ins. diam. aluminum cap, 24 ins. in the ground, in a small mound of stone.

From which

A ponderosa pine, 11 ins. diam., bears N. 69 1/2° W., 41.4 ft. dist., mkd. 1/4 S 33 BT on double blaze.

A ponderosa pine, 9 ins. diam., bears S. 59 1/2° E., 67.8 ft. dist., mkd. 1/4 S4 BT on double blaze.

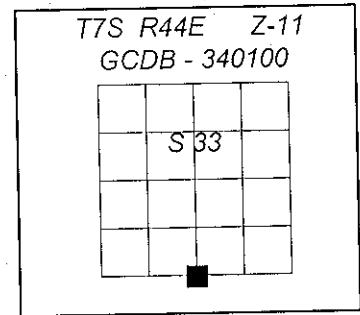

Description of corner evidence found:

Found a 2 1/2 ins. diam. aluminum pipe with a 3 1/4 ins. diam. aluminum cap, firmly set, projecting 3 ins. above ground, in rock collar, mkd. as shown,

From the recovered monument I find the bearing trees mkd. by Sundet

A ponderosa pine, 10 ins. diam., dead and down, bears S. 59 1/2° E., 67.8 ft. dist., with visible scribe on open blaze.

A ponderosa pine, 16 ins. diam., alive and healthy, bears N. 69 1/2° W., 41.4 ft. dist., with healed blaze.

Description of monument and accessories I established to perpetuate original location of this corner:

New bearing trees

A tamarack, 10 ins. diam., bears N. 69° E., 99.1 ft. dist., mkd. 1/4 S33 BT.

A ponderosa pine, 21 ins. diam., bears S. 70° E., 39.2 ft. dist., mkd. 1/4 S4 BT.

A Douglas fir, 19 ins. diam., bears S. 82° W., 49.9 ft. dist., mkd. 1/4 S4 BT.

CORS '02 geographic position:

Lat. 44°54'19.3" N


Long. 117°20'00.6" W

All bearing trees are painted with red bands, and have Bearing Tree (54-3) and Land Survey Monument (54-9) signs attached. All new bearing trees have a metal washer stamped "LS 2648" nailed in the side center.

Posted National Forest Boundary N. 09°07'57" E., east and west from corner with Property Boundary (54-2) signs, and a Land Survey Monument (54-9) sign on nearby post.

Witnesses: Kristina Powell and Matt Brockamp

Date: July 31, 2009

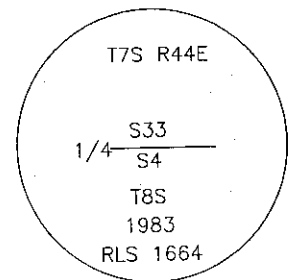

REGISTERED
PROFESSIONAL
LAND SURVEYOR

Ron Walter

OREGON
JANUARY 18, 1994
RON C. WALTER
2648

Renewal Date: June 30, 2010

Office of County Surveyor County of Baker
State of Oregon , I hereby certify that the within instrument was filed in this office
for record on the day of , 20
..... by
(COUNTY OFFICIAL) FILED Feb. 24, 2010 (DEPUTY)