

CERTIFIED RECORD OF LAND CORNER MONUMENTATION

History of original corner establishment:

Original corner established by Chet M. Foster, under contract approved October 28, 1872.

Record states:

Cor. 1 is a post mkd. WHP 1.

Corner remonumented by William L. Hanley, LS 1639, as described by Baker County Survey No. 8-44-10, filed October 28, 1980.

Record states

At position of found 4"x6" partially rotted wood post in small rock mound, set a 5/8" x 30" steel rebar.

Corner remonumented by Harry C. Hildebrand, LS 1898, as described by Baker County Corner Record No. 8-44-15, filed June 22, 1982.


Record states

I replaced William Hanley's rebar with a 2 1/2" x 32" brass capped steel pipe set 22 ins. in the ground in a mound of stones

From which

A white fir, 12 ins. diam., bears N. 58 1/4° E., 16.35 ft., mkd. COR 1/MS 11 BT.

A ponderosa pine, 9 ins. diam., bears N. 01 3/4° E., 25.30 ft., mkd. COR 1/MS 11 BT.

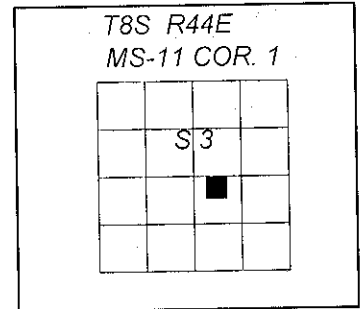

Description of corner evidence found:


Found a 2 1/2 ins. diam. steel pipe with a 2 1/2 ins. diam. brass cap, firmly set, 2 ins. above ground, in rock collar, mkd. as shown,

From the recovered monument I find the bearing trees mkd. by Hildebrand

Remains of a ponderosa pine, dead and down, bears N. 1 3/4° E., 25.3 ft. dist., with healed blaze.

A fir, 16 ins. diam., alive and healthy, bears N. 58 1/4° E., 16.4 ft. dist., with healed blaze.

Found guard post 3 ft. north with Land Survey Monument (54-9) sign.

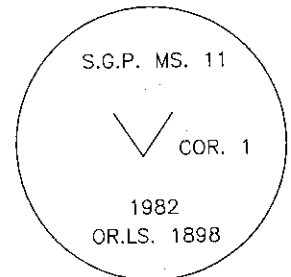

Description of monument and accessories I established to perpetuate original location of this corner:

New bearing tree

A white fir, 8 ins. diam., bears N. 9° W., 27.1 ft. dist., mkd. X BT, with washer in face.

CORS '02 geographic position:

Lat. 44°53'43.6" N
Long. 117°18'49.4" W

All bearing trees are painted with red bands, and have Bearing Tree (54-3) and Land Survey Monument (54-9) signs attached. Posted National Forest Boundary N. 51°54'40" W. and N. 37°35'07" E. from corner with Property Boundary (54-2) signs, and a Land Survey Monument (54-9) sign on nearby post.

Witnesses: Kristina Powell and Matt Brockamp

Date: July 31, 2009

REGISTERED
PROFESSIONAL
LAND SURVEYOR

Ron Walter

OREGON
JANUARY 18, 1994
RON C. WALTER
2648

Renewal Date: June 30, 2010

Office of _____ County Surveyor _____ County of _____ Baker
State of _____ Oregon _____, I hereby certify that the within instrument was filed in this office
for record on the _____ day of _____, 20____
_____ by _____
(COUNTY OFFICIAL) (DEPUTY)

FILED Feb. 24, 2010