

CERTIFIED RECORD OF LAND CORNER MONUMENTATION

History of original corner establishment:

Original corner established by Chet M. Foster, under contract approved October 28, 1872.

Record states:

Cor. 3 is a post mkd. WHP 3.

Corner remonumented by William L. Hanley, LS 1639, as described by Baker County Survey No. 8-44-10, filed October 28, 1980.

Record states

At position of found 4"x6" partially rotted wood post in small rock mound, set a 5/8" x 30" steel rebar.

Corner remonumented by Harry C. Hildebrand, LS 1898, as described by Baker County Corner Record No. 8-44-17, filed June 22, 1982.


Record states

I replaced Willaim Hanley's rebar with a 2 1/2" x 32" brass capped steel pipe set 28 ins. in the ground.

From which

A white fir, 10 ins. diam., bears S. 22 1/4° E., 14.24 ft., mkd. COR 3/MS 11 BT.

A white fir, 10 ins. diam., bears N. 72 1/4° W., 14.97 ft., mkd. COR 3/MS 11 BT.

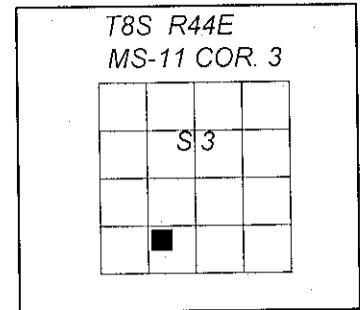

Description of corner evidence found:


Found a 2 1/2 ins. diam. steel pipe with a 2 1/2 ins. diam. brass cap, firmly set, 2 ins. above ground, in rock collar, mkd. as shown,

From the recovered monument I find the bearing trees mkd. by Hildebrand

Remains of a white fir stump, bear S. 22 1/4° E., 13.0 ft. dist. to stump hole, with dead and down fir alongside with visible scribe on open blaze. (S. 22 1/4° E., 14.2 ft., Hildebrand)

A white fir, 16 ins. diam., dead and down, bears N. 72 1/4° W., 15.0 ft. dist., with healed blaze.

Found guard post 3 ft. west with Land Survey Monument (54-9) sign.

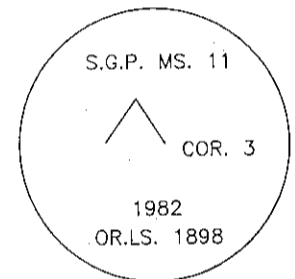

Description of monument and accessories I established to perpetuate original location of this corner:

New bearing tree

A tamarack, 10 ins. diam., bears S. 75° E., 9.4 ft. dist., mkd. X BT, on double blaze with washer in face.

A tamarack, 15 ins. diam., bears N. 6° W., 15.9 ft. dist., mkd. C3 MS11 BT, with washer in face.

CORS '02 geographic position:

Lat. 44°53'37.3" N
Long. 117°19'06.8" W

All bearing trees are painted with red bands, and have Bearing Tree (54-3) and Land Survey Monument (54-9) signs attached. Posted National Forest Boundary N. 36°51'43" E. and S. 52°47'03" E. from corner with Property Boundary (54-2) signs, and a Land Survey Monument (54-9) sign on nearby post.

Witnesses: Ron Walter, Kristina Powell and Nick Tressler

Date: July 24, 2009

REGISTERED
PROFESSIONAL
LAND SURVEYOR

OREGON
JANUARY 18, 1994
RON C. WALTER
2648

Renewal Date: June 30, 2010

Office of County Surveyor County of Baker
State of Oregon , I hereby certify that the within instrument was filed in this office
for record on the day of , 20

..... by

(COUNTY OFFICIAL) (DEPUTY)

FILED Feb. 24, 2010