

CERTIFIED RECORD OF LAND CORNER MONUMENTATION

History of original corner establishment:

Original corner established by Chet M. Foster, under contract approved October 28, 1872.

Record states:

Cor. 6 is a post mkd. WHP 6.

Corner reestablished by William L. Hanley, LS 1639, as described by Baker County Survey No. 8-44-10, filed October 28, 1980.

Record states

At position determined by survey, set a 5/8" x 30" steel rebar.

Corner remonumented by Harry C. Hildebrand, LS 1898, as described by Baker County Corner Record No. 8-44-20, filed June 22, 1982.


Record states

I replaced William Hanley's rebar with a 2 1/2" x 32" brass capped steel pipe set 22 ins. in the ground.

From which

A white fir, 8 ins. diam., bears S. 58 3/4° E., 31.37 ft., mkd. COR 6/MS 11 BT.

A ponderosa pine, 8 ins. diam., bears S. 52 1/2° W., 23.21 ft., mkd. COR 6/MS 11 BT.

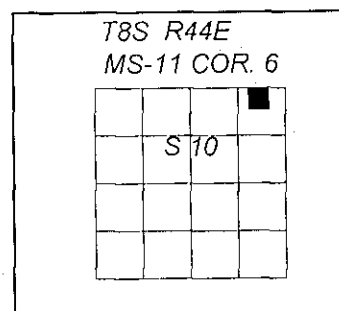

Description of corner evidence found:


Found a 2 1/2 ins. diam. steel pipe with a 2 1/2 ins. diam. brass cap, firmly set, 5 ins. above ground, mkd. as shown.

From the recovered monument I find the bearing trees mkd. by Hildebrand

A white fir, 15 ins. diam., alive and healthy, bears S. 58 3/4° E., 31.4 ft. dist., with healed blaze.

A pine, 8 ins. diam., dead and down, bears S. 52 1/2° W., 23.2 ft. dist.

Found guard post 2 ft. south-west'ly with Land Survey Monument (54-9) sign.

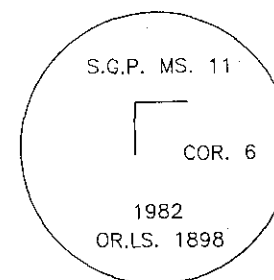

Description of monument and accessories I established to perpetuate original location of this corner:

New bearing tree

A red fir, 10 ins. diam., bears N. 45° W., 33.5 ft. dist., mkd. C6 MS11 BT, with washer in face.

CORS '02 geographic position:

Lat. 44°53'27.6" N
Long. 117°18'39.9" W

All bearing trees are painted with red bands, and have Bearing Tree (54-3) and Land Survey Monument (54-9) signs attached. Posted National Forest Boundary S. 76°21'06" W. and N. 13°39'51" W. from corner with Property Boundary (54-2) signs, and a Land Survey Monument (54-9) sign on nearby post.

Witnesses: Ron Walter and Nick Tressler

Date: July 31, 2009

REGISTERED
PROFESSIONAL
LAND SURVEYOR

Ron Walter

OREGON
JANUARY 18, 1994
RON C. WALTER
2648