
## CERTIFIED RECORD OF LAND CORNER MONUMENTATION

## History of Original Corner Establishment:


TOWNSHIP LINE PLAT AND NOTES SURVEYED BY WALDEN IN 1873 UNDER CONTRACT NO. 198.

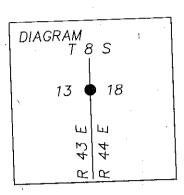

## Description of corner evidence found:


FOUND ORIGINAL STONE 10"X6"X12" MARKED "1\4" IN N-S-E-W FENCE FOUND MOUND OF STONE NE AND SW OF 1/4 STONE BOTH 3'X3'

Description of monument and accessories I established to perpetuate the original location of this corner:

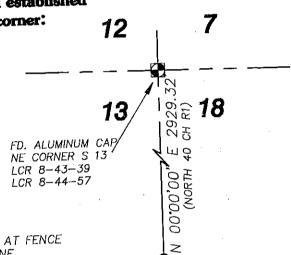

SET  $\frac{5}{8}$ " X 30' STEEL PIN WITH CAP PLS 66818 AT FENCE INTERSECTION IN THE LOCATION OF FOUND STONE.

ACCESSORIES ESTABLISHED FROM CORNER LOCATION: SET %" X 30" STEEL PIN S 44.38'25" W. 5.57 FEET IN STONE MOUND. SET 5%" X 30" STEEL PIN S 47'15'11" W 4.78 FEET IN STONE MOUND.

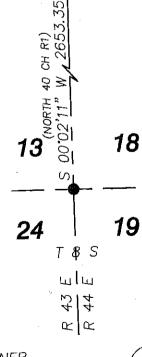

I, STEVEN C. WELLINGTON CERTIFY THAT THIS CORNER WAS PROPERLY REESTABLISHED BY MIKE ENGEBRITSON AND JEFF ENGEBRITSON ON SEPTEMBER 5, 2012.

FILED \_ May 8, 2013 BAKER COUNTY SURVEYOR SURVEY NO. 8-43-47/8-44-154 CORNER PRES. NO. \_ CORNER PRES. NO.

REGISTERED **PROFESSIONAL** 

OREGON STEVEN C. WELLINGTON 66818

RENEWS JUNE 30, 2014