


CERTIFIED RECORD OF LAND CORNER MONUMENTATION

History of original corner establishment:

Corner established by N. O. Walden under GLO contract no. 198 dated July 15, 1873.

Surveyor's General records state:

Set a granite rock 14 x 12 x 6 ins. 8 ins. in the ground for corner to secs 35, 36, 1, 2.

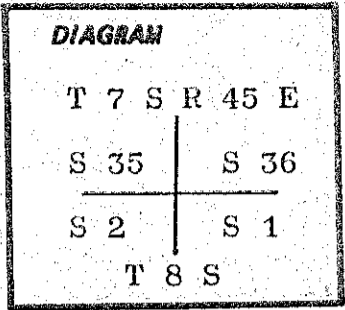

Description of corner evidence found:

From Survey No. 7-45-3 filed May 19, 1975, found an ancient fence line running south from the right-of-way fence of Baker County Road No. 729. County Road Book No. 2, page 36-37, indicates the road centerline was constructed along the section line.

Re-established the corner at the intersection of ancient fence line and centerline of the County Road No. 729 as determined by north and south right-of-way fences.

Description of monument and accessories I established to perpetuate the original location of this corner:

Set a 2½ in. brass disc with a 3½ in. stem, 5/8 diam. flush with the surface of County Road No. 729.

Brass disc marked thus:

T 7 S R 45 E
S 35 S 36
S 2 S 1
T 8 S
CS 1979

I hereby certify that the above corner monument was properly re-established under my supervision on Nov. 7, 1979 and witnessed by Bill Hanley and Jeff Townsend.

REGISTERED PROFESSIONAL LAND SURVEYOR

James D. Hanley

OREGON SEPTEMBER 23, 1977 JAMES D. HANLEY 1206

Office of..... County of.....
 State of....., I hereby certify that the within instrument was filed in this office
 for record on the..... day of....., 19.....

..... by
 (COUNTY OFFICIAL) (DEPUTY)

Form R6-7100-51 (9/71)

FILED Dec 12, 1979
 BAKER COUNTY SURVEYOR
 SURVEY NO. 7-45-43
8-45-1