


CERTIFIED RECORD OF LAND CORNER MONUMENTATION

History of original corner establishment:

Corner established by N. O. Walden under GLO contract no. 198 dated July 15, 1873.

Surveyor's General records state:

Set a granite boulder 16 x 10 x 10 ins. 8 ins. in the ground for 1/4 sec. cor.

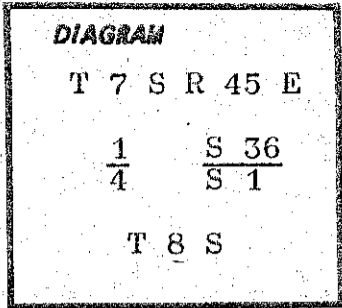

Description of corner evidence found:

From Survey No. 7-45-3 filed May 19, 1975, found an ancient fence line running north and south from the right-of-way fences of Baker County Road No. 729. County Road Book No. 2, page 36-37, indicates the road centerline was constructed along the section line.

Re-established the corner at the intersection of ancient fence lines and centerline of the County Road No. 729 as determined by north and south right-of-way fences.

Description of monument and accessories established to perpetuate the original location of this corner:

Set a 2½ in. brass disc with a 3½ in. stem, 5/8 in. diam, flush with the surface of County Road No. 729.

Brass disc marked thus: T 7 S R 45 E

$\frac{1}{4}$      $\frac{S\ 36}{S\ 1}$   
T 8 S  
CS 1979

I hereby certify that the above corner monument was properly re-established under my supervision on Nov. 7, 1979 and witnessed by Bill Hanley and Jeff Townsend.

**REGISTERED  
PROFESSIONAL  
LAND SURVEYOR**

*James D. Hanley*  
**OREGON**  
SEPTEMBER 23, 1977  
**JAMES D. HANLEY**  
1206

Office of..... County of.....  
State of....., I hereby certify that the within instrument was filed in this office  
for record on the..... day of....., 19.....  
..... by .....  
(COUNTY OFFICIAL) (DEPUTY)

Form R6-7100-51 (9/71)

FILED Dec 12, 1979  
BAKER COUNTY SURVEYOR  
SURVEY NO. 7-45-44  
8-45-2