


CORNER SEARCH, EVALUATION, MONUMENTING and BOUNDARY MARKING

From _____ To _____

Region _____ Forest _____

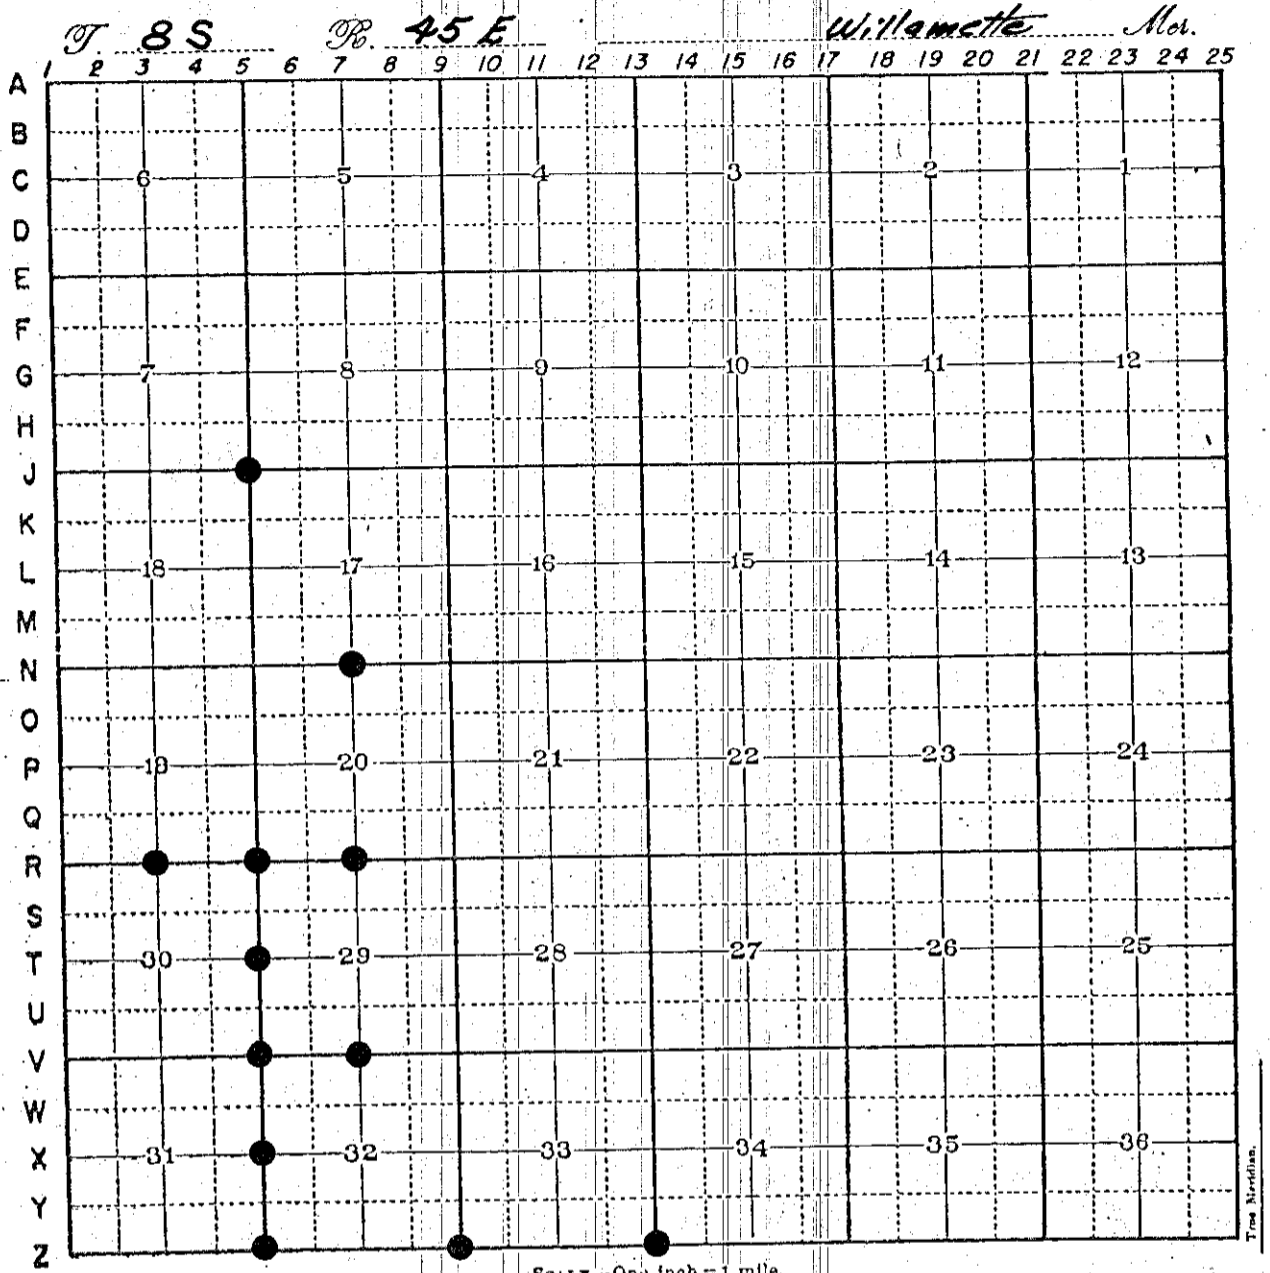

LEGEND

- Corners searched for
- ⊗ Evidence believed acceptable

- Corners monumented
- Boundary posted (line only in red)

USDA-FOREST SERVICE

GPO 900,245

7100-53

REGISTERED
PROFESSIONAL
LAND SURVEYOR

James H. Hambleton
4-9-80

OREGON
JULY 10, 1964
JAMES H. HAMBLETON
645

FILED 4-9-80
BAKER COUNTY SURVEYOR
SURVEY NO. 8-45-3