


CERTIFIED RECORD OF LAND CORNER MONUMENTATION

History of original corner establishment:

Nicolas O. Walden made the original survey under Contract No. 198, dated July 15, 1873. At the section corner location common to sections 33, 34 & 3, 4, T 8 & 9 S, R 45 E, he set a sandstone 14 x 8 x 8, 8" in ground.

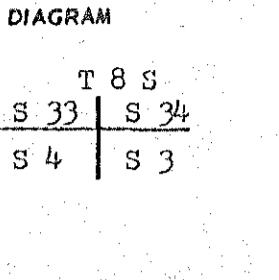

Description of corner evidence found:

At the section corner location mentioned above, I found a stone of which I could not identify its type and being 16 x 9 x 8 in place in a mound of stone near a bluff. No markings were visible on the stone.

Description of monument and accessories I established to perpetuate the original location of this corner

At the section corner location I set a 2" x 30" galv. iron pipe with a brass cap approx. 24" above surface of ground as area is very rocky. I then placed the original stone on the north side of monument and then made a large mound of stone 4 ft. dia. and $2\frac{1}{2}$ ft. high around the monument and the original stone. There are no accessories available.


Cap stamped:

T 8 S

S 33	S 34
S 4	S 3
T 9 S R 45 E	

1980

ORLS 645

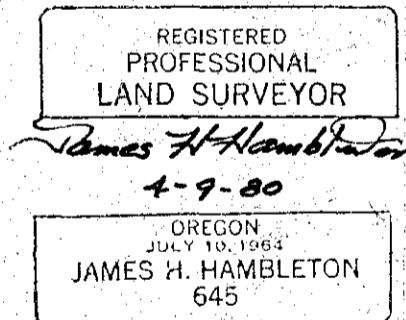

Office of..... County of.....
State of....., I hereby certify that the within instrument was filed in this office
for record on the day of

(COUNTY OFFICIAL)

by

(DEPUTY)

FILED 4-9-80

BAKER COUNTY SURVEYOR
SURVEY NO. 8-45-4

* GPO 796-333