


**CERTIFIED RECORD OF LAND CORNER MONUMENTATION**

**History of original corner establishment:**

Nicolas O. Walden made the original survey under Contract No. 198, dated July 15, 1873. At the section corner location common to Sections 32, 33 & 45, T 8 & 9 S, R 45 E, he set a granite rock 12 x 10 x 6, 6" in ground.

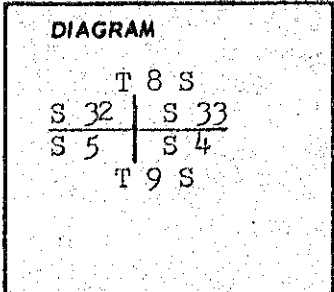

**Description of corner evidence found:**

At the above mentioned section corner, I found a granite type stone 14 x 10 x 7 on the surface in a small mound of stone. No markings were visible on the stone. No other evidence was in area and rock was limited in area.

**Description of monument and accessories I established to perpetuate the original location of this corner**

At the section corner location I set a 2" x 30" galv. iron pipe with a brass cap approx. 18" above surface of ground as area is gravelly. I then placed the original stone on the north side of monument and then made a large mound stone 3 ft. dia. and 1 1/2 ft. high around the monument and the original stone. There are no accessories available.

Cap stamped:

T 8 S  

S 32	S 33
S 5	S 4

T 9 S R 45 E  
1980  
ORLS 645

REGISTERED  
PROFESSIONAL  
LAND SURVEYOR

*James H. Hambleton*  
4-9-80

OREGON  
JULY 16, 1964  
JAMES H. HAMBLETON  
645

Office of ..... County of .....  
State of ..... , I heraby certify that the within instrument was filed in this office  
for record on the ..... day of .....  
..... by .....  
(COUNTY OFFICIAL) (DEPUTY)

FILED 4-9-80  
BAKER COUNTY SURVEYOR  
SURVEY NO. 8-45-6