


CERTIFIED RECORD OF LAND CORNER MONUMENTATION

History of original corner establishment:

W.B. Barr made the original survey under contract No. 355, dated June 14, 1880. At the section corner location common to Sections 19, 20, 29, & 30, T 8 S R 45 E, he set a marked basalt rock 24 x 12 x 8.

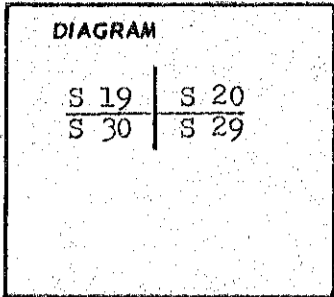

Description of corner evidence found:

At the above mentioned section corner location I found a basalt stone 29 x 12 x 9 and being marked with 2 notches on the south face and 5 notches on the east face and being in a mound of stone.

Description of monument and accessories I established to perpetuate the original location of this corner

At the section corner location I set a 2" x 30" galv. iron pipe with a brass cap approx. 24" above surface as area is very rocky and impossible to dig. I placed the original stone along the west edge of the monument and then placed a large mound of stone 4 ft. dia. and 2½ ft. high about both the monument and the original stone.

Cap stamped:
T 8 S

S 19	S 20
S 30	S 29
R 45 E	
1980	
ORLS 645	

REGISTERED
PROFESSIONAL
LAND SURVEYOR

James H. Hambleton

4-9-80

OREGON
JULY 10, 1964
JAMES H. HAMBLETON
645

Office of County of
 State of, I hereby certify that the within instrument was filed in this office
 for record on the day of
 by
 (COUNTY OFFICIAL) (DEPUTY)

FILED 4-9-80
 BAKER COUNTY SURVEYOR
 SURVEY NO. 8-45-7