


CERTIFIED RECORD OF LAND CORNER MONUMENTATION

History of original corner establishment:

W.B. Barr made the original survey under Contract No. 355, dated June 14, 1880. At the $\frac{1}{4}$ corner location common to Sections 19 & 30, T 8 S R 45 E, he set a marked basalt rock 24 x 15 x 8 in a raised mound of rock as per instructions.

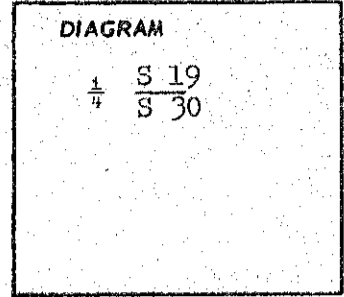

Description of corner evidence found:

At the above mentioned $\frac{1}{4}$ corner location I found a basalt stone 24 x 16 x 9 and being marked $\frac{1}{4}$ on the north face. Stone was in place in a mound of stone.

Description of monument and accessories established to perpetuate the original location of this corner

At the $\frac{1}{4}$ corner location I set a 2" x 30" galv. iron pipe with brass cap approx. 22" above ground as area is very rocky. Placed original stone along south side of monument with the $\frac{1}{4}$ marking facing the pipe. I then placed a large mound of stone about both the monument and original stone approx. 4 ft. dia. and 2 ft. high covering the monument.

Cap stamped:
T 8 S
 $\frac{1}{4}$ S 19
S 30
R 45 E
1980
ORLS 645

REGISTERED
PROFESSIONAL
LAND SURVEYOR

James H. Hambleton
4-9-80

OREGON
JULY 10, 1964
JAMES H. HAMBLETON
645

Office of County of
State of , I hereby certify that the within instrument was filed in this office
for record on the day of
..... by
(COUNTY OFFICIAL) (DEPUTY)

FILED 4-9-80
BAKER COUNTY SURVEYOR
SURVEY NO. 8-45-8