


CERTIFIED RECORD OF LAND CORNER MONUMENTATION

History of original corner establishment:

W.B. Barr made the original survey under Contract No. 355, dated June 14, 1880. At the $\frac{1}{4}$ corner location common to Sections 20 & 29, T 8 S R 45 E, he set marked basalt rock 12 x 10 x 6 in a raised mound of rock as per instructions.

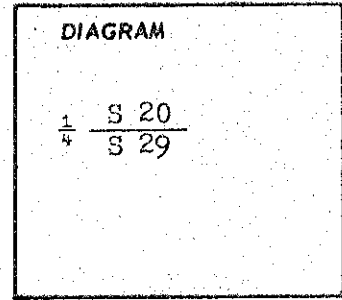

Description of corner evidence found:

At the above mentioned $\frac{1}{4}$ corner location, I found a basalt stone 12 x 12 x 8 with $\frac{1}{4}$ marked on its face and lying with $\frac{1}{4}$ face up with a mound of stone along side.

Description of monument and accessories I established to perpetuate the original location of this corner

At the $\frac{1}{4}$ corner location I set a 2" x 30" galv. iron pipe with a brass cap being placed 1.4 feet east of the original stone and buried with 8" above surface. I left the original stone in place and placed a large mound of stone $3\frac{1}{2}$ ft. dia. and 2 ft. high covering both the monument and the original stone.

Cap stamped:

T 8 S
 $\frac{1}{4}$ S 20
S 29
R 45 E
1980
ORLS 645

REGISTERED
PROFESSIONAL
LAND SURVEYOR

James H. Hambleton
4-9-80

OREGON
JULY 10, 1964
JAMES H. HAMBLETON
645

Office of County of
State of, I hereby certify that the within instrument was filed in this office
for record on the day of
..... by
(COUNTY OFFICIAL) (DEPUTY)

FILED 4-9-80
BAKER COUNTY SURVEYOR
SURVEY NO. 8-45-9