


CERTIFIED RECORD OF LAND CORNER MONUMENTATION

History of original corner establishment:

W.B. Barr made the original Survey under Contact No. 355, dated June 14, 1880. At the $\frac{1}{4}$ corner location common to Sections 29 & 32, T 8 S R 45 E, he set a marked basalt rock 12 x 12 x 6 in a raised mound of rock.

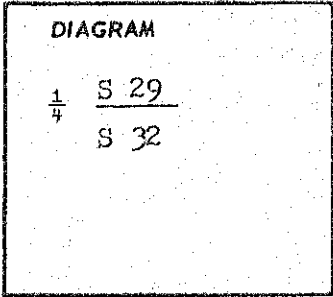

Description of corner evidence found:

At the above mentioned $\frac{1}{4}$ corner location I found a basalt stone 13 x 12 x 6 with $\frac{1}{4}$ marked faintly on the north face. The stone was in place and leaning to the north with a small mound of stone placed about the rock; it was evident some rock had rolled away as corner is on a hill side.

Description of monument and accessories I established to perpetuate the original location of this corner

At the $\frac{1}{4}$ corner location I set a 2" x 30" galv. iron pipe with brass cap approx. 8" above surface. I buried the original stone along the north face of the iron pipe, then placed a mound of stone 3 feet dia. and 1 $\frac{1}{2}$ feet high about the monument. There were no accessories available.

Cap stamped:
 T 8 S
 $\frac{1}{4}$ S 29
 S 32
 R 45 E
 1980
 ORLS 645

REGISTERED
 PROFESSIONAL
 LAND SURVEYOR

James H. Hambleton
 4-9-80

OREGON
 JULY 31, 1964
 JAMES H. HAMBLETON
 645

Office of..... County of.....
 State of....., I hereby certify that the within instrument was filed in this office
 for record on the..... day of.....
 by
 (COUNTY OFFICIAL) (DEPUTY)

FILED 4-9-80
 BAKER COUNTY SURVEYOR
 SURVEY NO. 8-45-11