


CERTIFIED RECORD OF LAND CORNER MONUMENTATION

History of original corner establishment:

W.B. Barr made the original survey under Contract No. 355, dated June 14, 1880. At the  $\frac{1}{4}$  corner location common to Sections 29 & 30, T 8 S R 45 E, he set a marked basalt rock 24 x 12 x 12 in a raised mound of rock as per instructions.

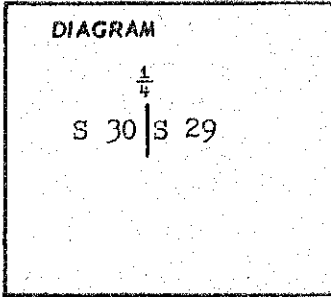

Description of corner evidence found:

At the above mentioned  $\frac{1}{4}$  corner location, I found a basalt stone 26 x 12 x 11 in place with  $\frac{1}{4}$  marked on the west face, with a mound of stone about the original stone.

Description of monument and accessories I established to perpetuate the original location of this corner

At the  $\frac{1}{4}$  corner location I set a 2" x 30" galv. iron pipe with brass cap approx. 20" above surface as area is very rocky. I placed the original stone on the east side of the monument with the  $\frac{1}{4}$  marking facing the pipe. I then placed a large mound of stone 4 feet dia. and 2 feet high about the monument covering both the brass cap and original stone. There was no accessories available.

Cap stamped:

T 8 S

$\frac{1}{4}$

S 30 | S 29

R 45 E

1980

ORLS 645

REGISTERED  
PROFESSIONAL  
LAND SURVEYOR

*James H. Hambleton*

4-9-80

OREGON  
JULY 10, 1954  
JAMES H. HAMBLETON  
645

Office of..... County of.....

State of....., I hereby certify that the within instrument was filed in this office

for record on the..... day of.....

..... by .....

(COUNTY OFFICIAL)

(DEPUTY)

FILED 4-9-80

BAKER COUNTY SURVEYOR

SURVEY NO. 8-45-12