


CERTIFIED RECORD OF LAND CORNER MONUMENTATION

History of original corner establishment:

W.B. Barr made the original survey under contract No. 355, dated June 14, 1880. At the corner location common to Sections 7, 8, 17 & 18, T 8 S R 45 E, he set a marked basalt rock 30 x 24 x 29 and a raised mound of stone alongside. From which: A pine 20" dia. bears N 78 W, 35 lks. dist.

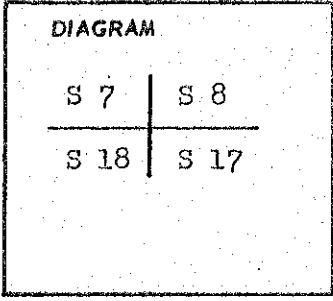

Description of corner evidence found:

At the above mentioned section corner location, I found a basalt stone 30 x 24 x 29, with 4 notches on south edge and 5 notches on east edge. I also found a pine 36" dia. that bears N 78 W, 35 lks. from the stone, though there is no evidence that this tree was ever blazed and scribed.

Description of monument and accessories I established to perpetuate the original location of this corner

At the corner location I set a 2" x 30" galv. iron pipe with brass cap in a large mound of stone as a large rock prevented burying the pipe. I placed the original stone along the East face of the iron pipe. I set no new accessories.

Cap stamped:

T 8 S  

S 7	S 8
S 18	S 17

R 45 E  
1980  
ORLS 645

REGISTERED PROFESSIONAL LAND SURVEYOR
---------------------------------------------

*James H. Hambleton*  
4-9-80

OREGON JULY 10, 1963 JAMES H. HAMBLETON 645
------------------------------------------------------

Office of ..... County of .....  
State of ..... , I hereby certify that the within instrument was filed in this office  
for record on the ..... day of .....  
..... by .....  
(COUNTY OFFICIAL) (DEPUTY)

FILED 4-9-80  
BAKER COUNTY SURVEYOR  
SURVEY NO. 8-45-13